


T15S. R. 25E.

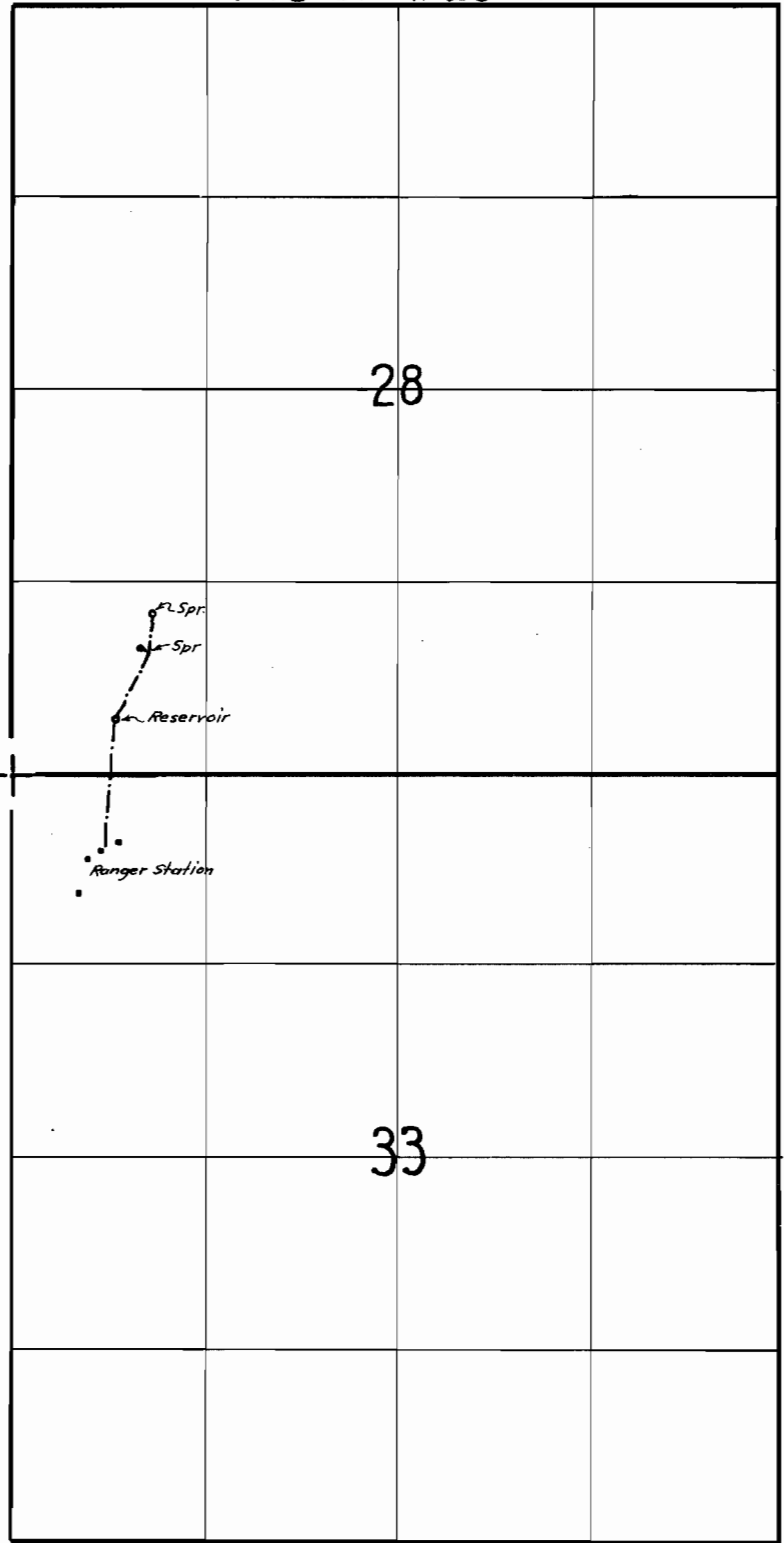

FINAL PROOF SURVEY
UNDER

Application No. 19004 Permit No. 14689

IN NAME OF

U.S. Forest Service (Ochoco)

Surveyed July 16, 1941, by Clara Cummings