


TOWNSHIP 38 S. RANGE 11 1/2 E.

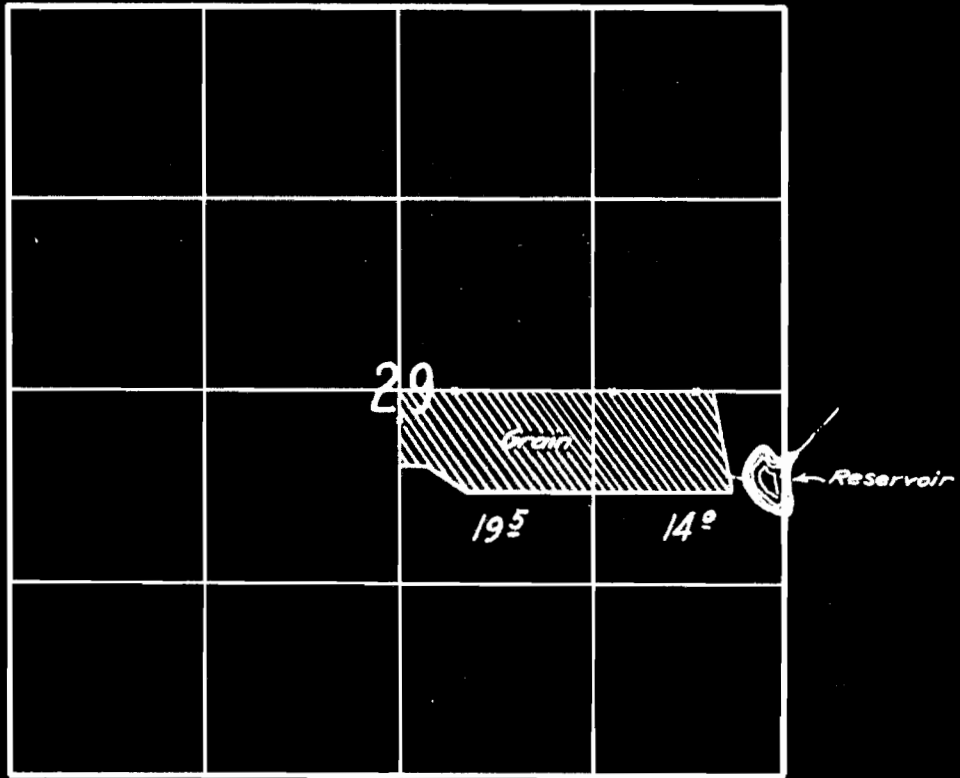

**FINAL PROOF SURVEY**

UNDER

R-19146

R-761

Application No. 19109

Permit No. 14714

IN NAME OF

*Guy Barton*

Surveyed *20 July 1941*, by *Edward Cummings*