


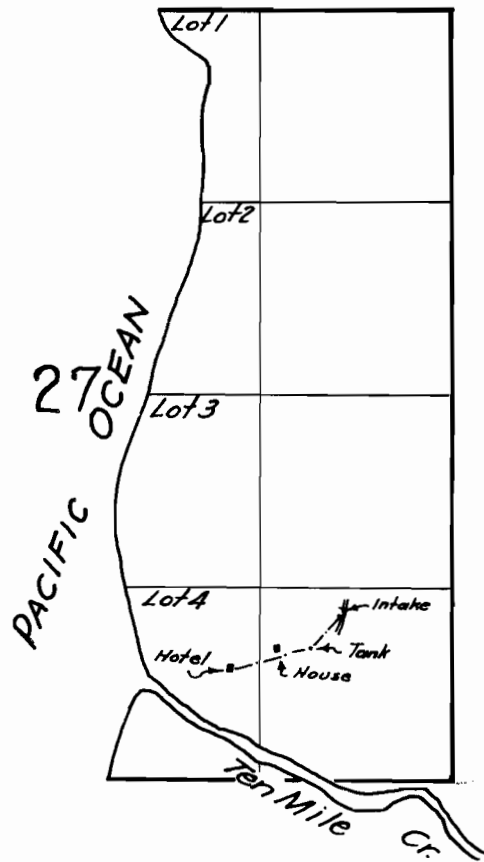

FINAL PROOF SURVEY

UNDER

Application No. 19121 Permit No. 14758

IN NAME OF

George P. Stonefield & W. L. Bathurst

Surveyed Aug. 6, 1941, by Ed. Hummery