


TOWNSHIP 12 S RANGE 11 & 12 W.

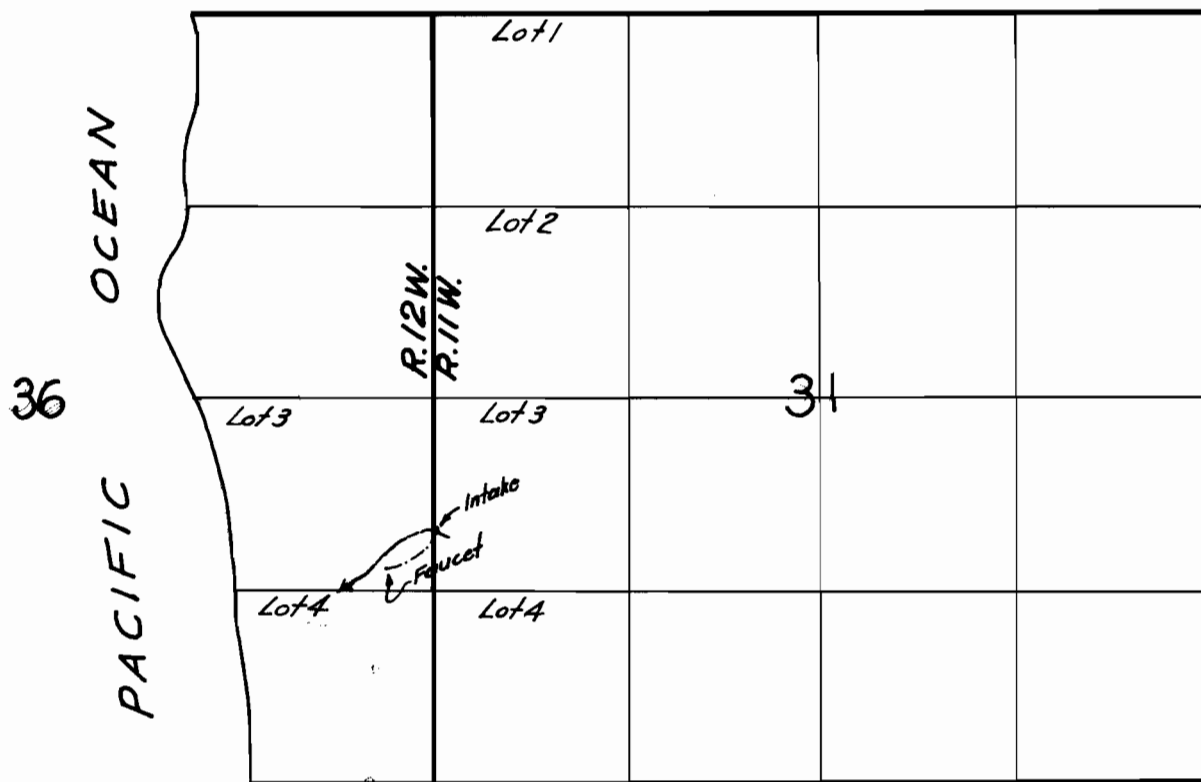

FINAL PROOF SURVEY
UNDER

Application No. 19202 Permit No. 14796

IN NAME OF

Chandler P. Brown

Surveyed Aug 7, 1941, by Ed Cummings