


App 19258
Permit 14858

T23S
R6E
Sec 18

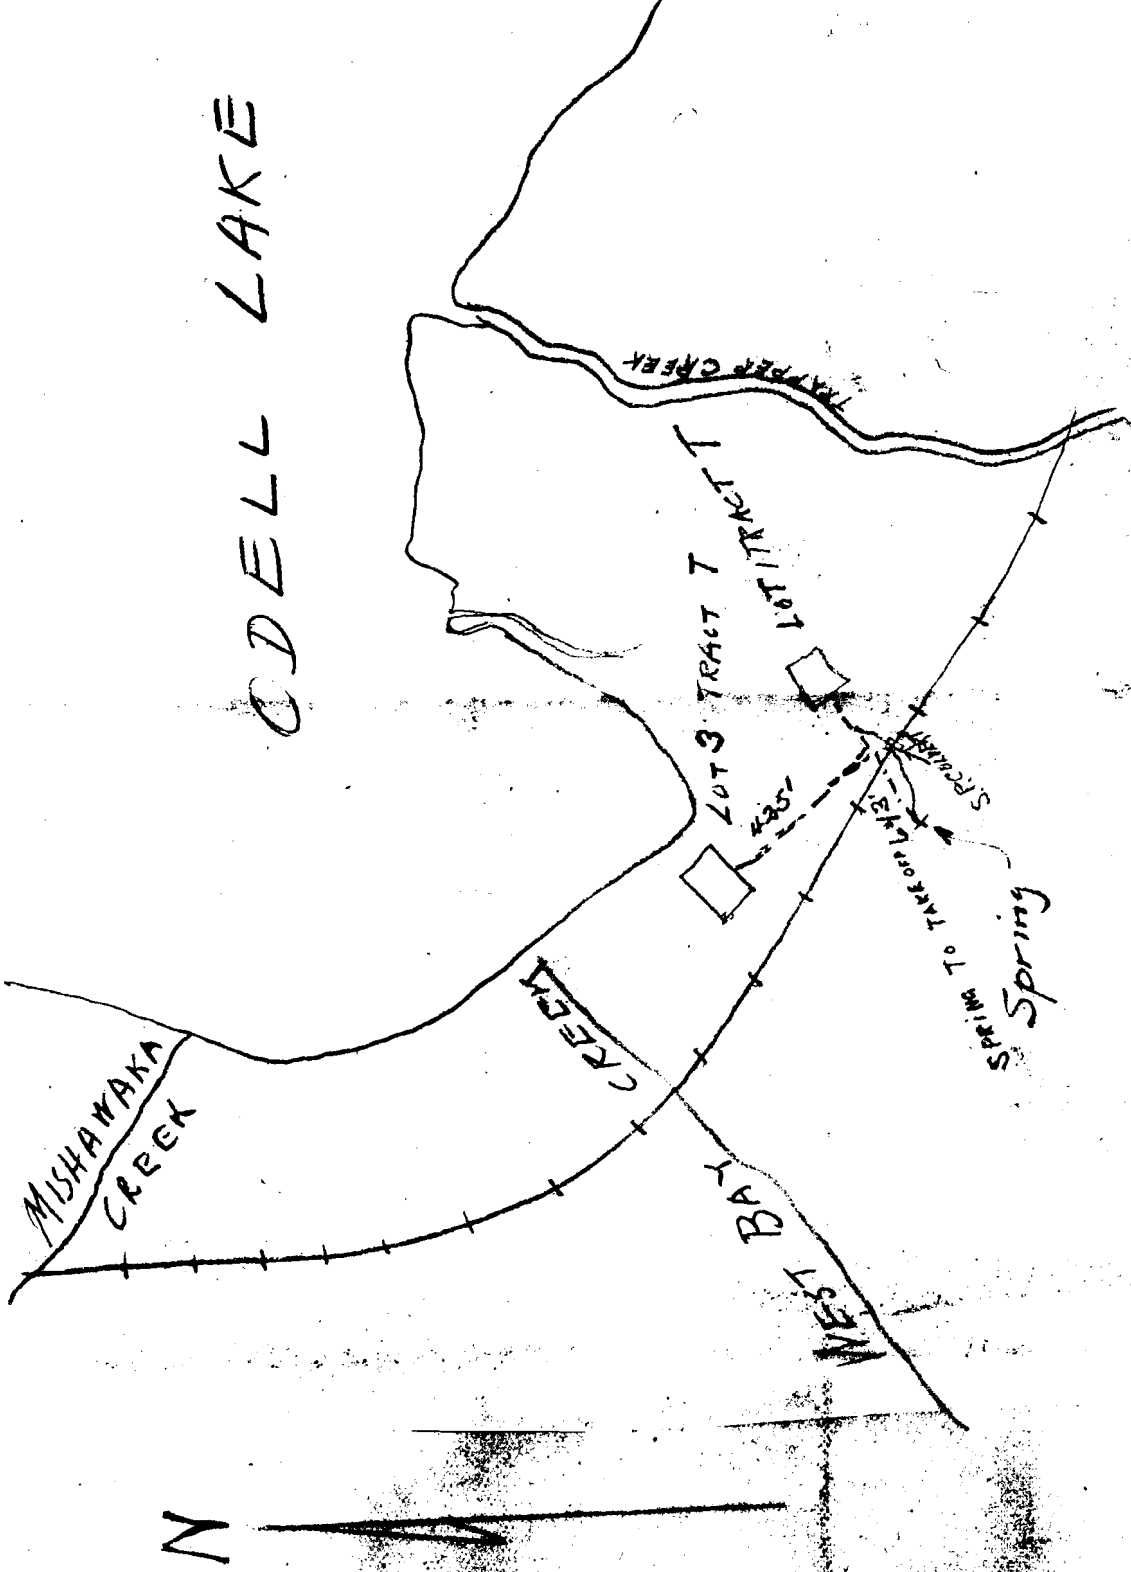

Application No 19258