

SECTION

E

Water Resources

Water Rights

Oregon - Umatilla


Bear Wallow Guard Sta.

TOWNSHIP 3 S, RANGE 33 E, W. M.

Per 14997
14340

North

2303'

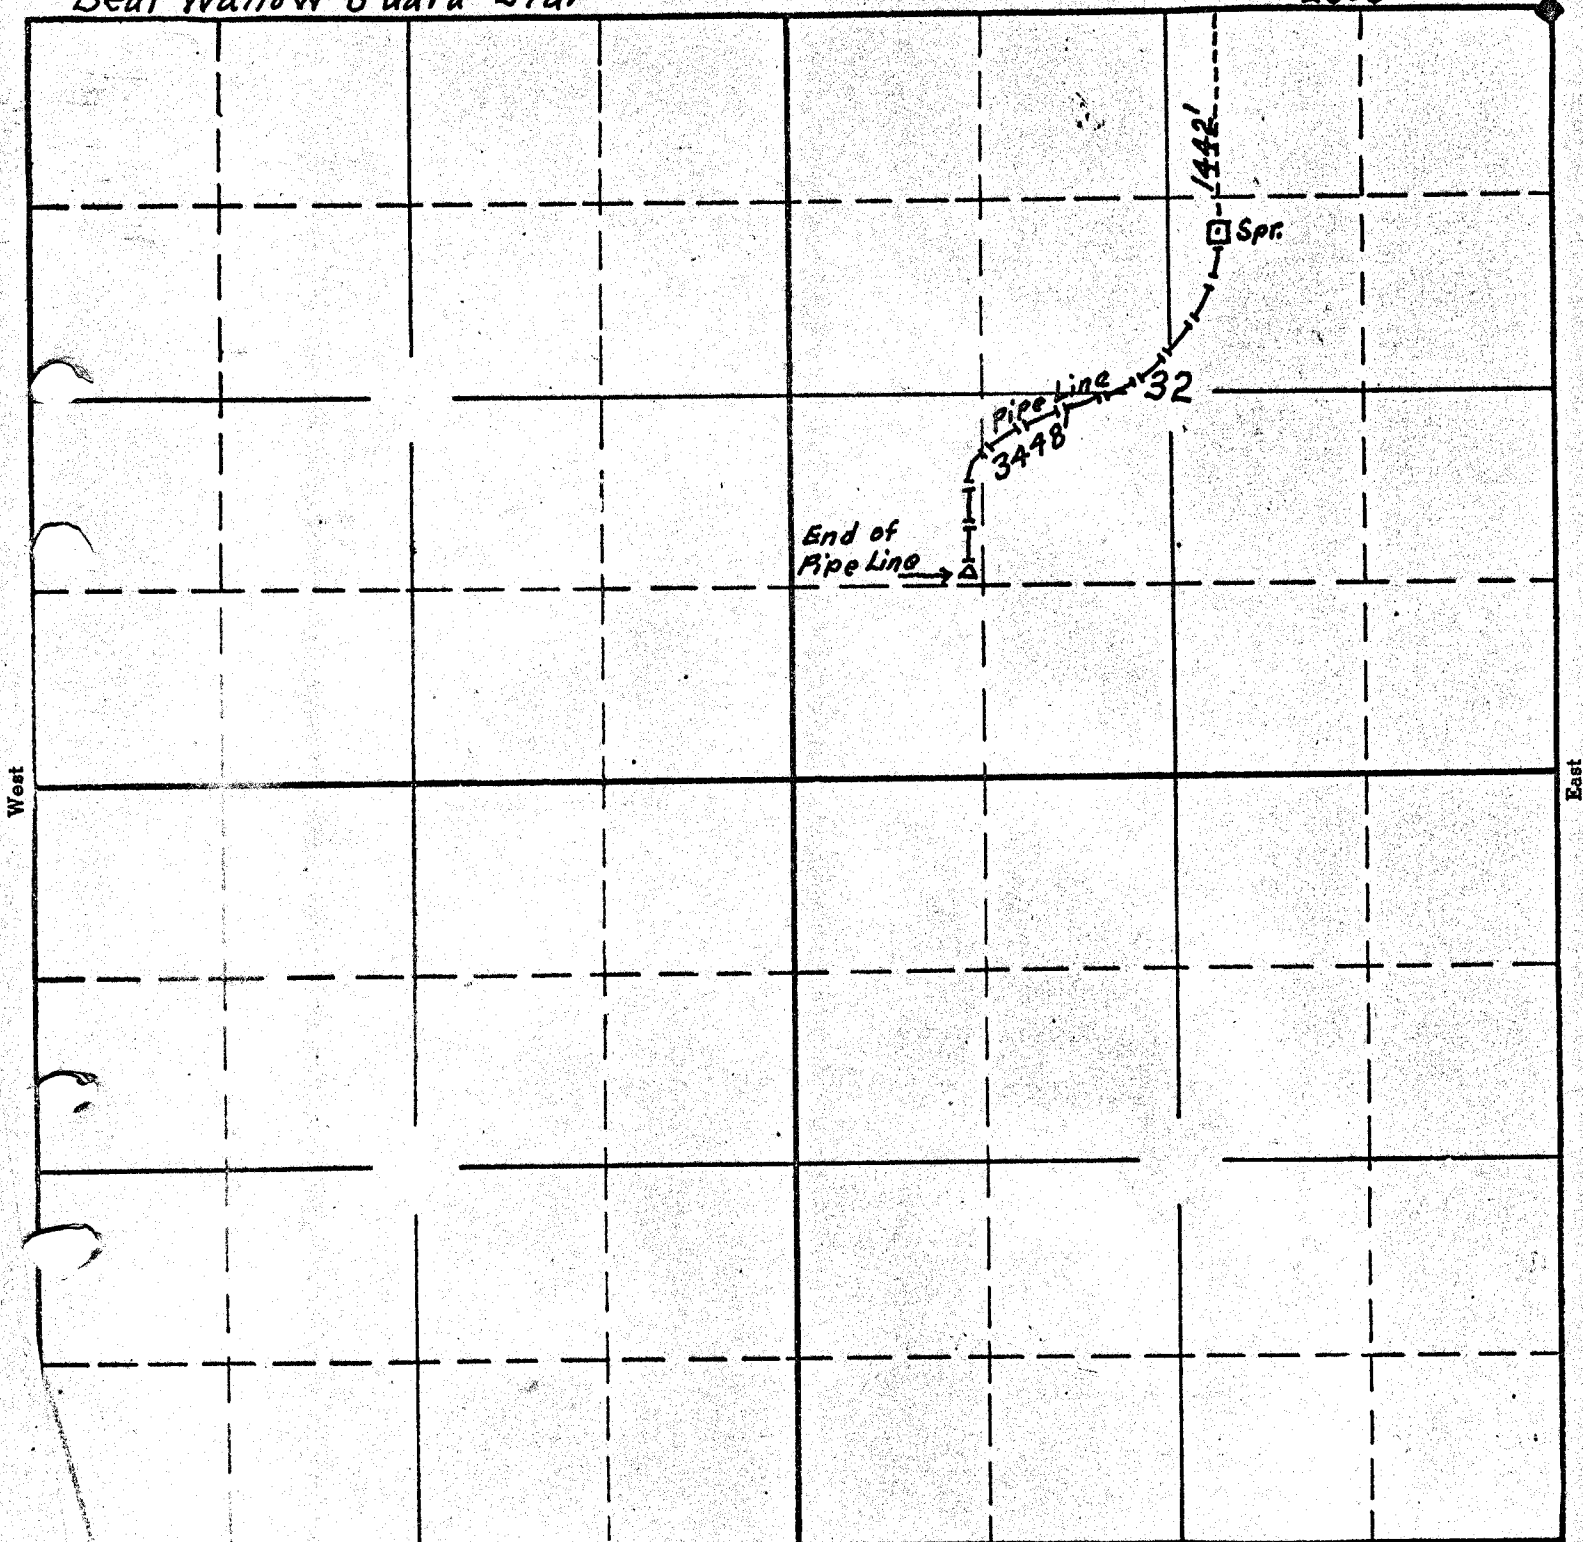

South

RECEIVED

JUN 19 1941

TATE ENGINEER
SALEM, OREGON

14377 ORC
6-8
APPLICATION No. 19577
PERMIT No. 14997