


TOWNSHIP 14S, RANGE 4W

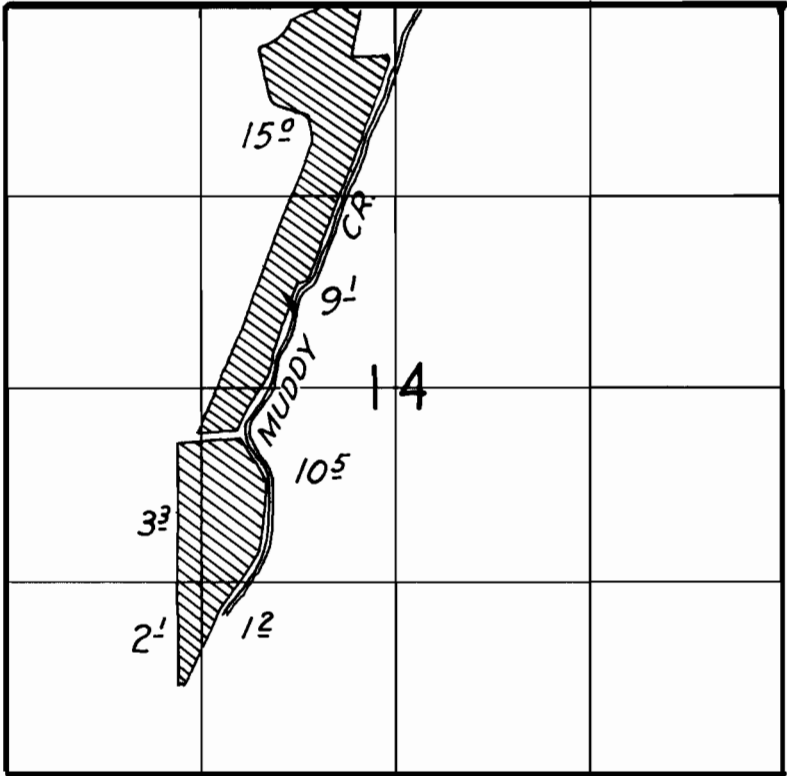

FINAL PROOF SURVEY
UNDER

Application No. 17797 Permit No. 13476

IN NAME OF

O. D. Kropf

Surveyed May 21, 1941, by C. L. Cummings