


TOWNSHIP 7 S., RANGE 5 W.

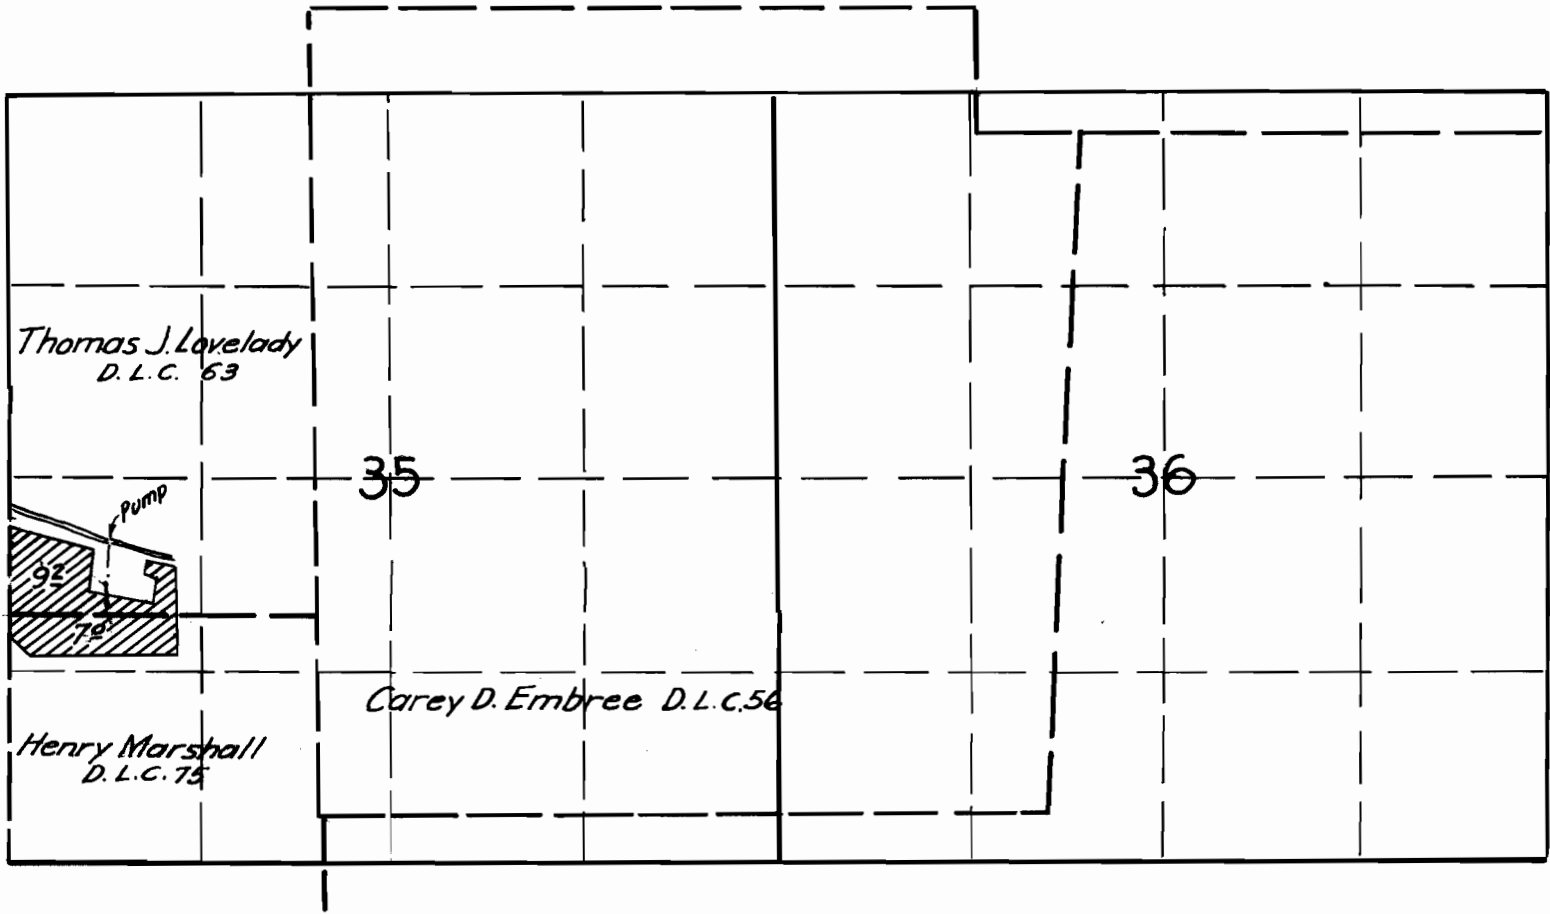

**FINAL PROOF SURVEY**

UNDER

Application No. 18003 Permit No. 13675

IN NAME OF

Henry Weurch

Surveyed May 14, 1941, by Ed. Cummings