


TOWNSHIP 8 N. RANGE 6 W. WM.

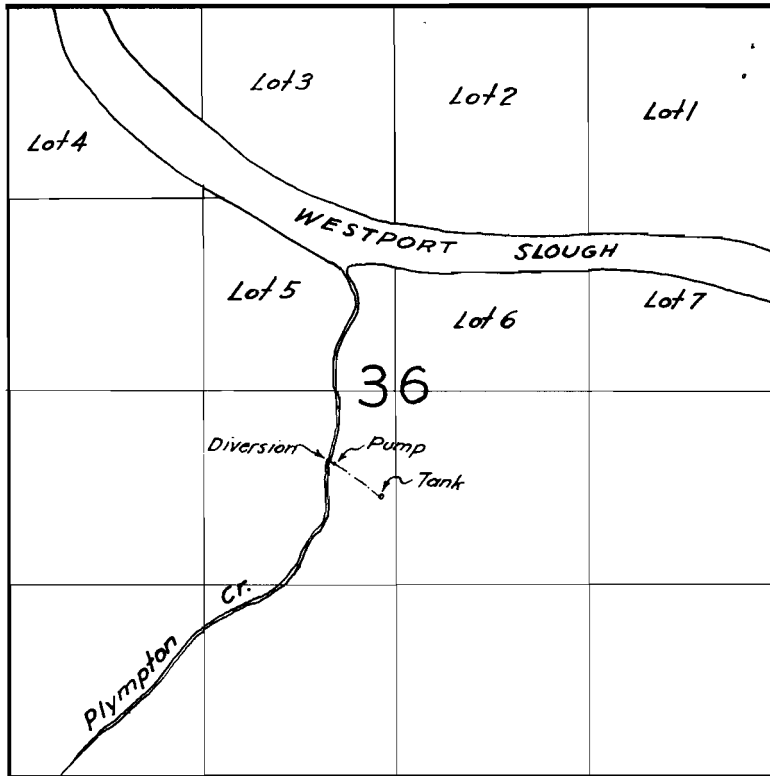

**FINAL PROOF SURVEY**  
UNDER

Application No. 18528 Permit No. 14213  
IN NAME OF

Spokane Portland & Seattle Ry. Co.  
Surveyed Aug 12, 1941, by Chester Cummings