


U-138 07c
4-6

Application No. U.138
Permit No. U.131

Sec. 32
Tp. 2. N.
R. 19. E. N.

U-131

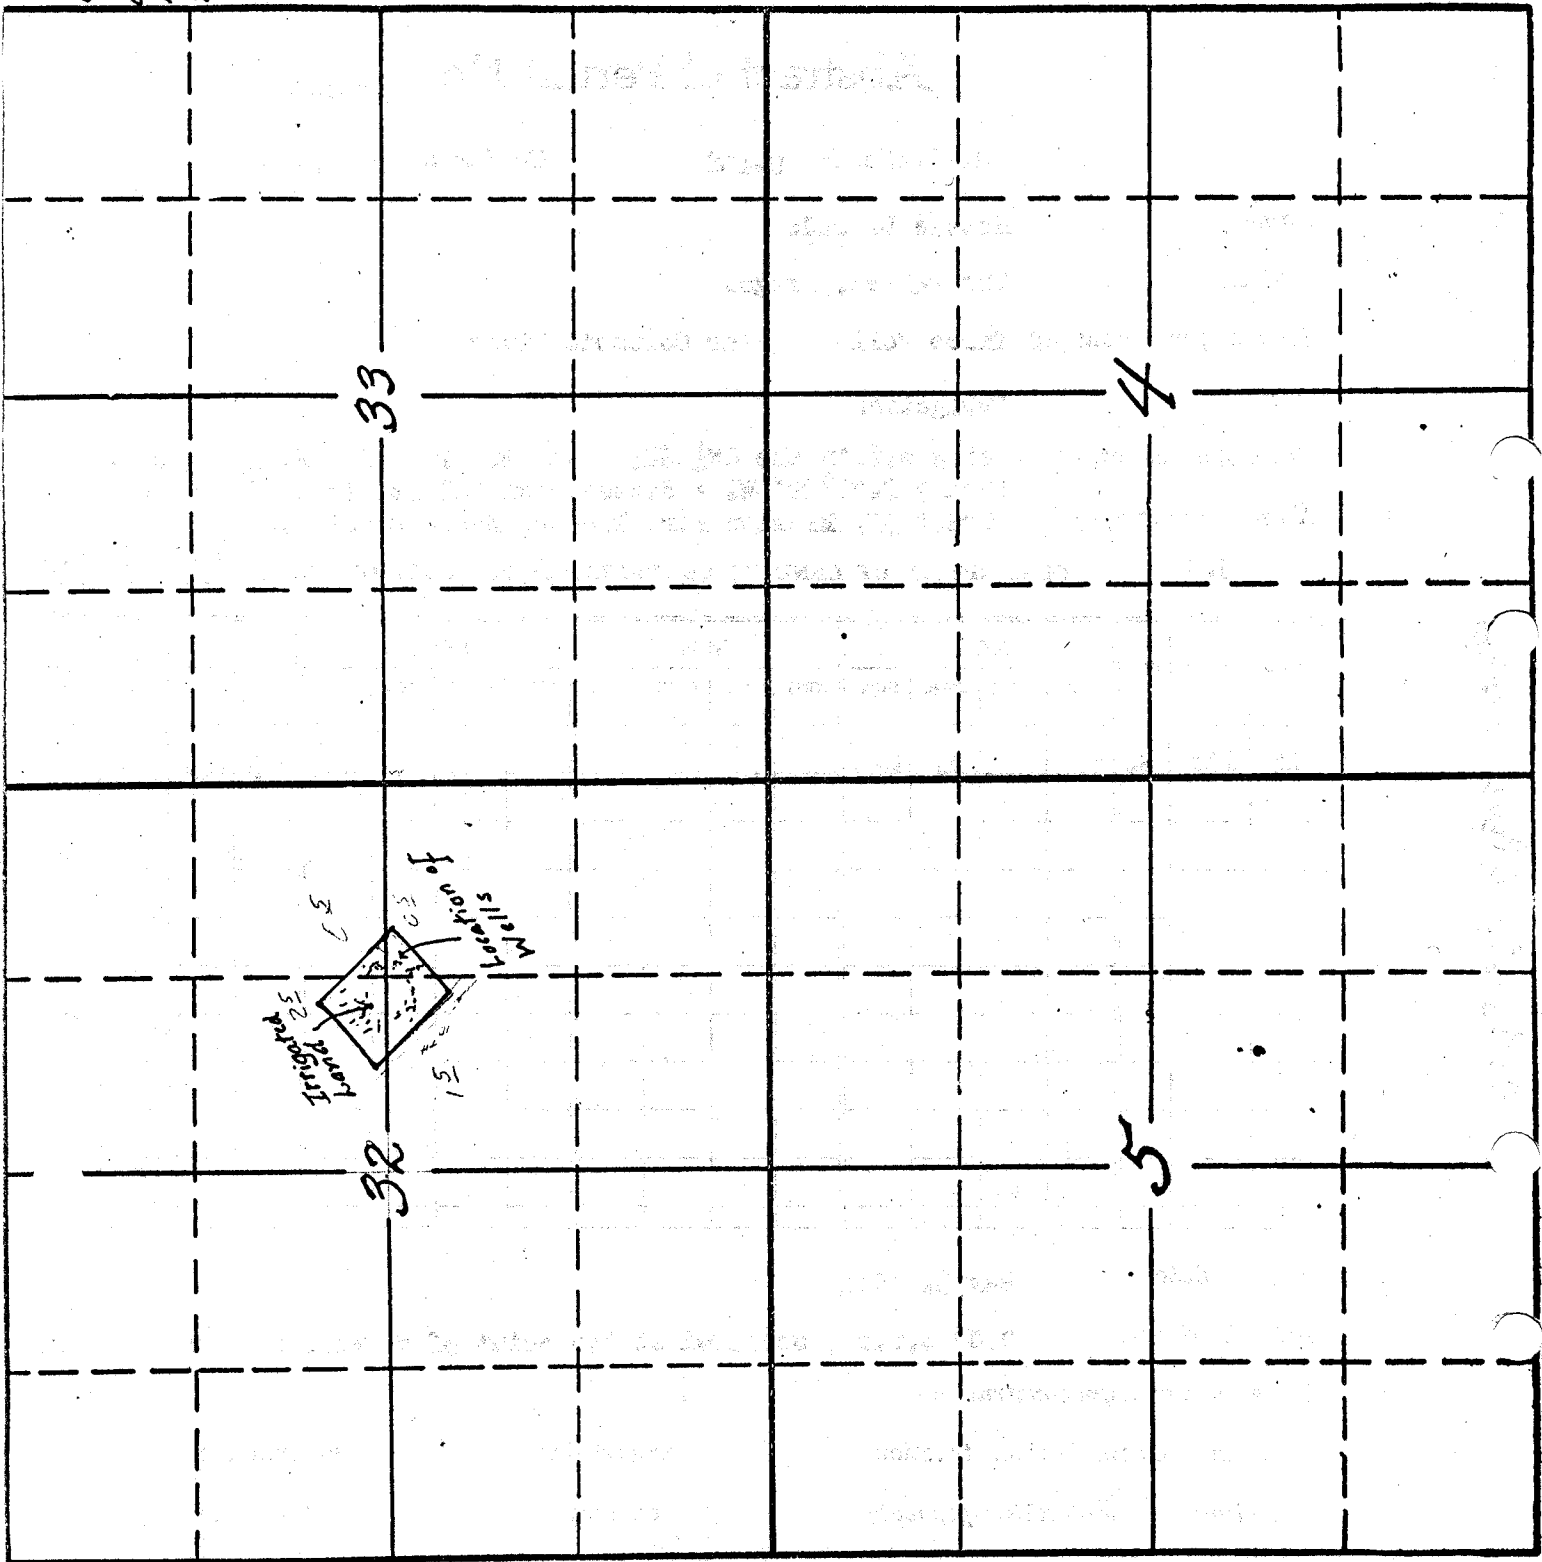

RECEIVED
MAY 3 1941
STATE ENGINEER
SALEM, OREGON