


T. 6 S.. R. 5 W. W.M.

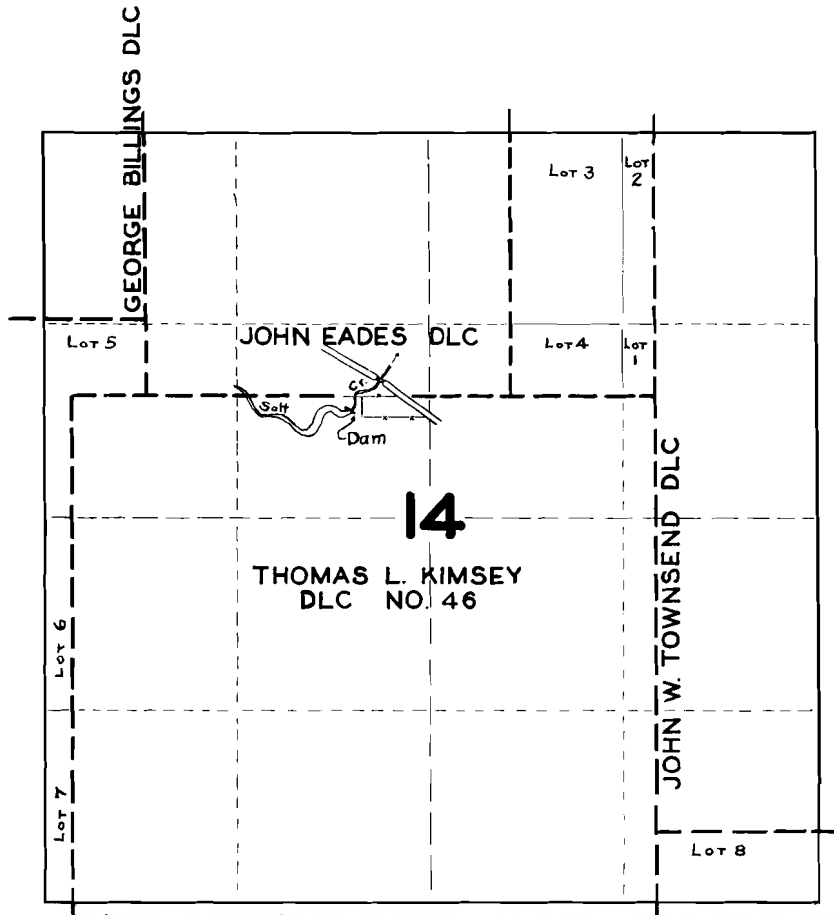

FINAL PROOF SURVEY UNDER

Application No. R-18021 Permit No. R-729

IN FAVOR OF

Karl Bruinsma

Surveyed June 9, 1942, by Geoff Paderman