


T. 6 S., R. 6 AND 7 W. W.M.

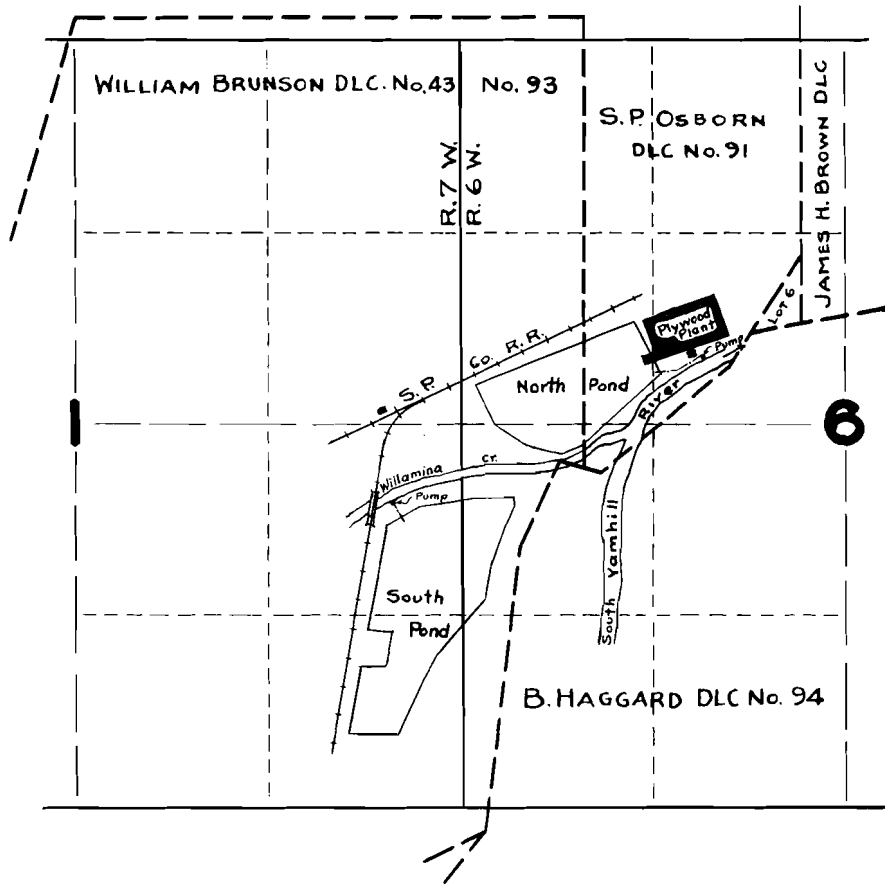

FINAL PROOF SURVEY UNDER

Application No. 19368 / 12369 Permit No. 15022 / R-768

IN NAME OF

Pacific Plywood Corporation

Surveyed Aug. 18, 1942, by Geoff. Maderman