


OFFICE OF STATE ENGINEER  
RECEIVED  
NOV 20 1916  
SALEM, OREGON,

Sec. 11, T. 9, S. R. 14, East

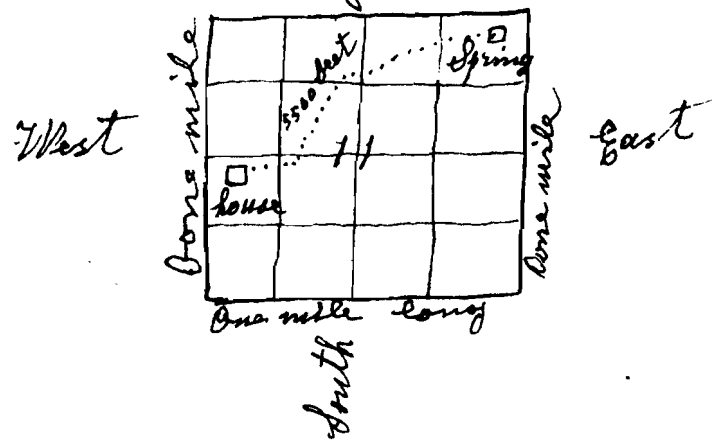

Gottfried Kamper

Application No. 5237  
Permit No. 3166