


T. 8 S., R. 11 W. W.M.

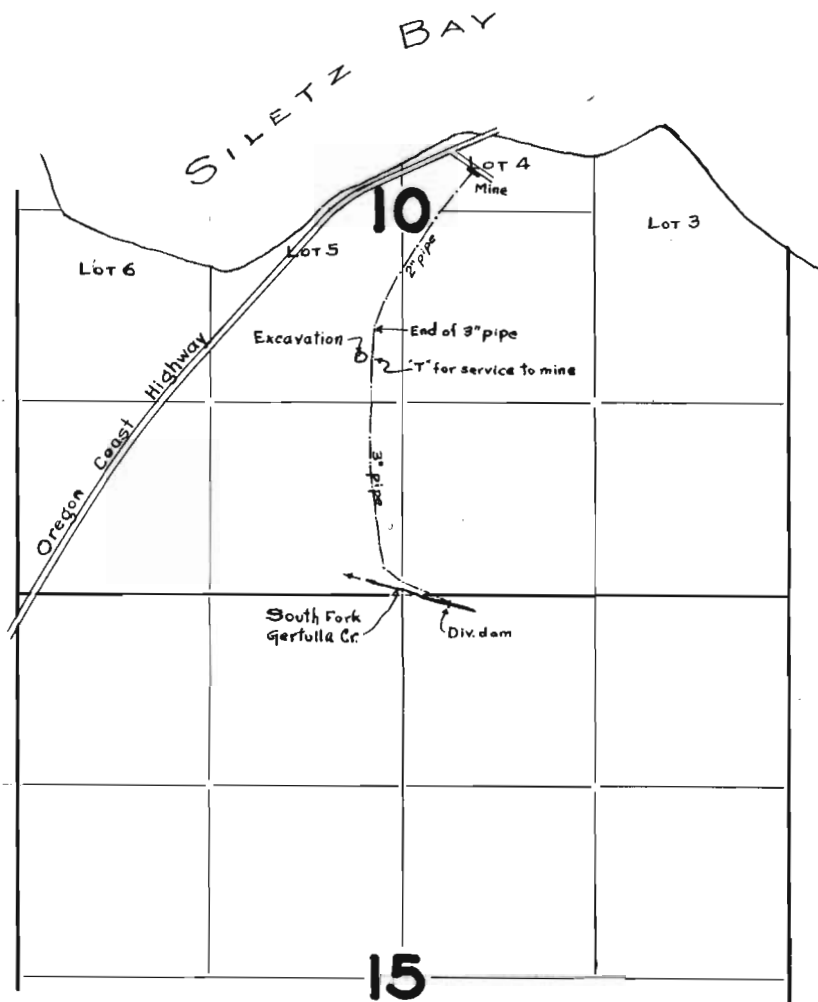

FINAL PROOF SURVEY UNDER

Application No. 12152 Permit No. 8584

IN NAME OF

Blanche E. Kirkpatrick

Surveyed Sept 9 1942, by Geo. W. Maderman