


T. 11 S., R. 11 W. W.M.

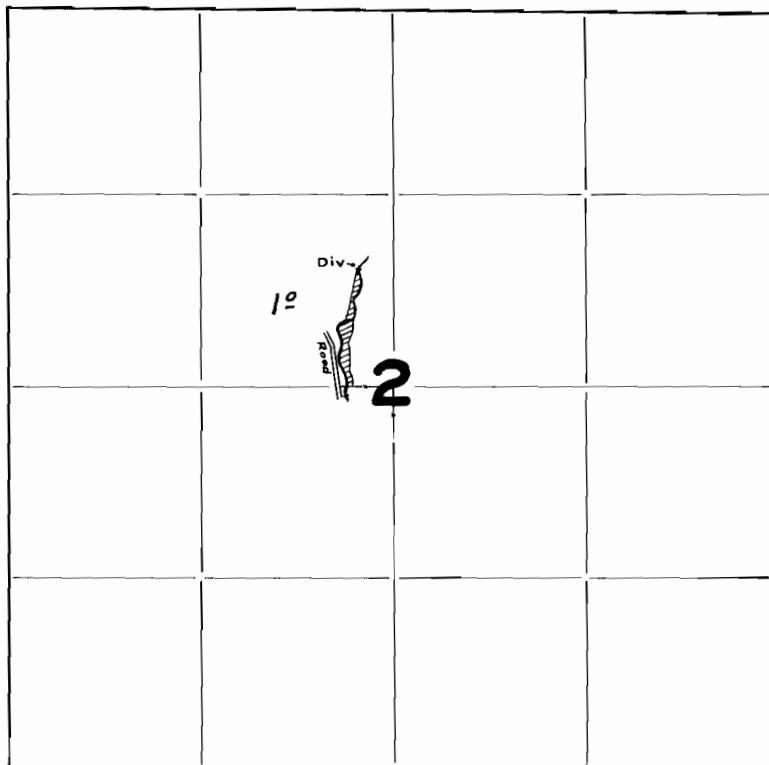

FINAL PROOF SURVEY
UNDER

Application No. 15952 Permit No. 11790

IN NAME OF

W. H. Osburn

Surveyed Sept. 11, 1942, by Geol. Nederman