


T. 3 N., R. 10 W. W.M.

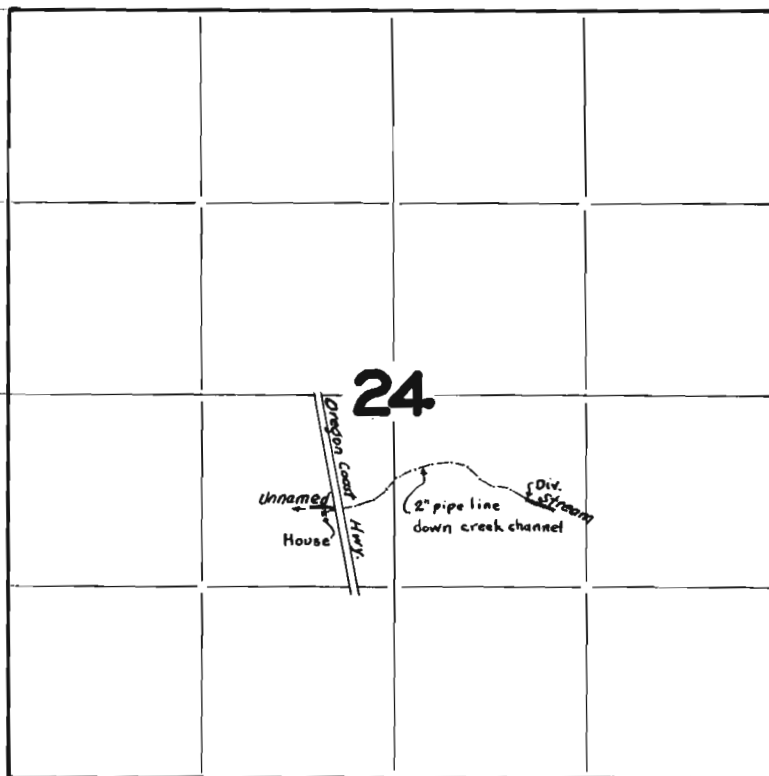

FINAL PROOF SURVEY
UNDER

Application No. 15989 Permit No. 11814
IN NAME OF

Mr. & Mrs. James C. Knudson

Surveyed Aug. 19, 1942, by Geo. W. Paderman