


# T. 6 S., R. 1 E. W.M.

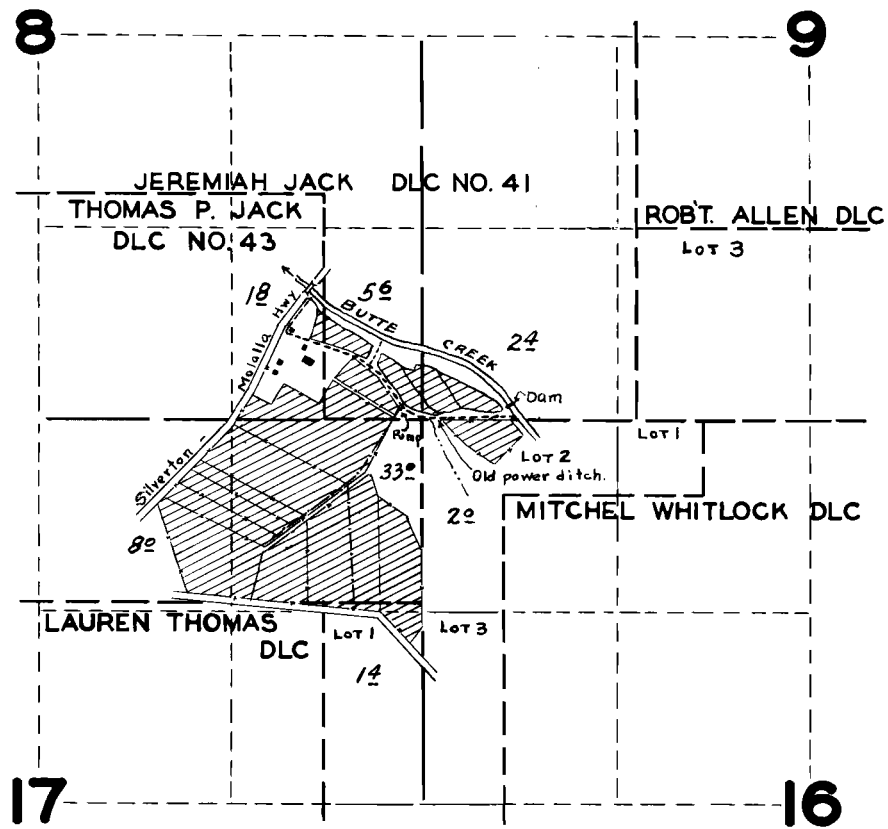

## FINAL PROOF SURVEY

UNDER

Application No. 16018 Permit No. 11846

IN NAME OF

L. R. Lima

Surveyed July 8 1942, by Geo. W. Adelman