


# T.14 S., R. 5 W. W.M.

## SECTION 17

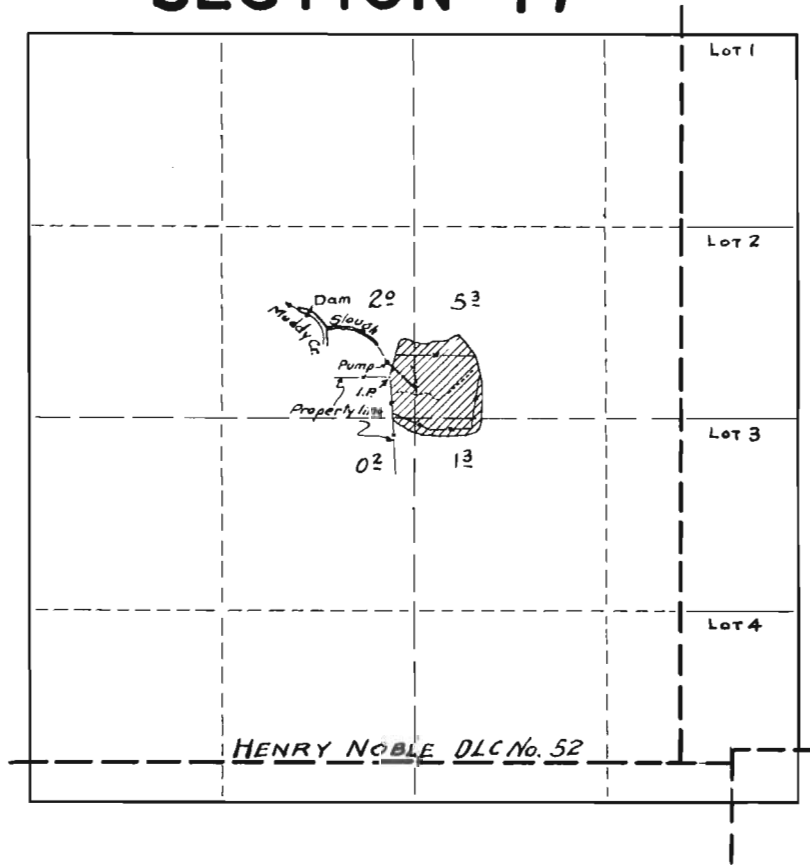

### FINAL PROOF SURVEY UNDER

Application No. 16152 Permit No. 11963

IN NAME OF

Wilbur F. Starr

Surveyed Sept. 3 1942, by Scott Mademan