


TOWNSHIP 3 S., RANGE 1 E.

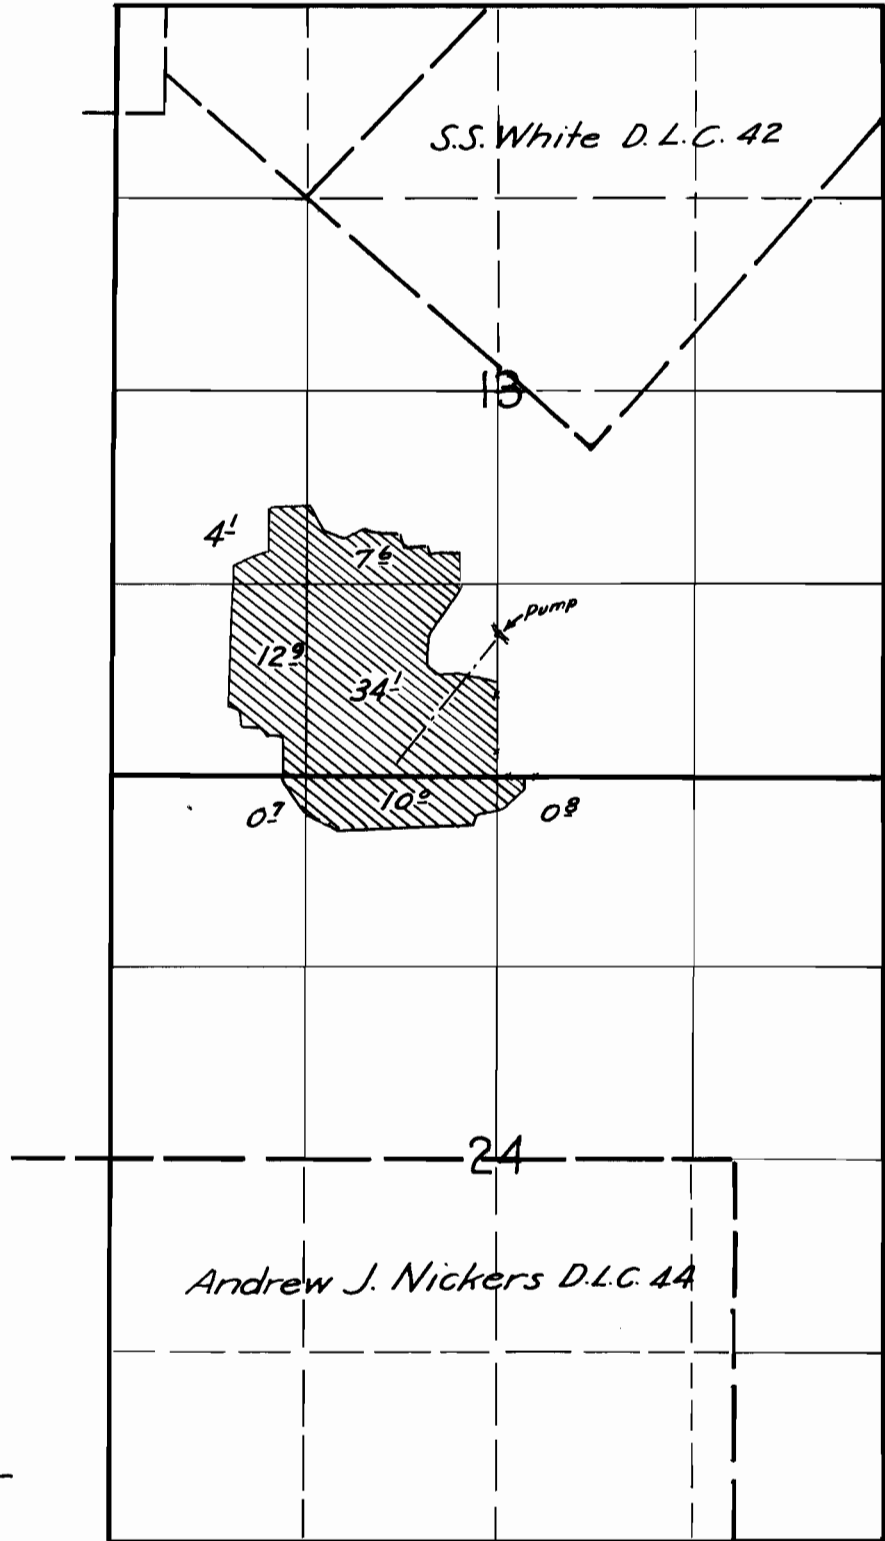

FINAL PROOF SURVEY
UNDER

Application No. 16160 Permit No. 11975

IN NAME OF

Stahely Brothers

Surveyed May 27 1941, by [Signature]