


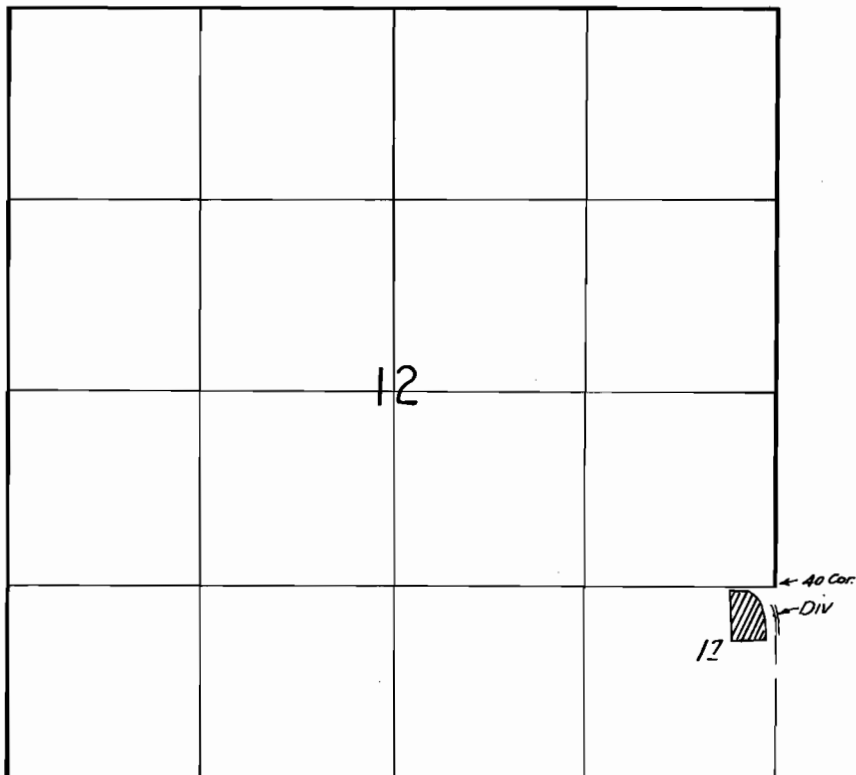

FINAL PROOF SURVEY

UNDER

Application No. 16305 Permit No. 12105

IN NAME OF

Sid Smith

Surveyed May 24, 1941, by Chester Humphrey