


T. 41 S., R. 12 W. W.M.

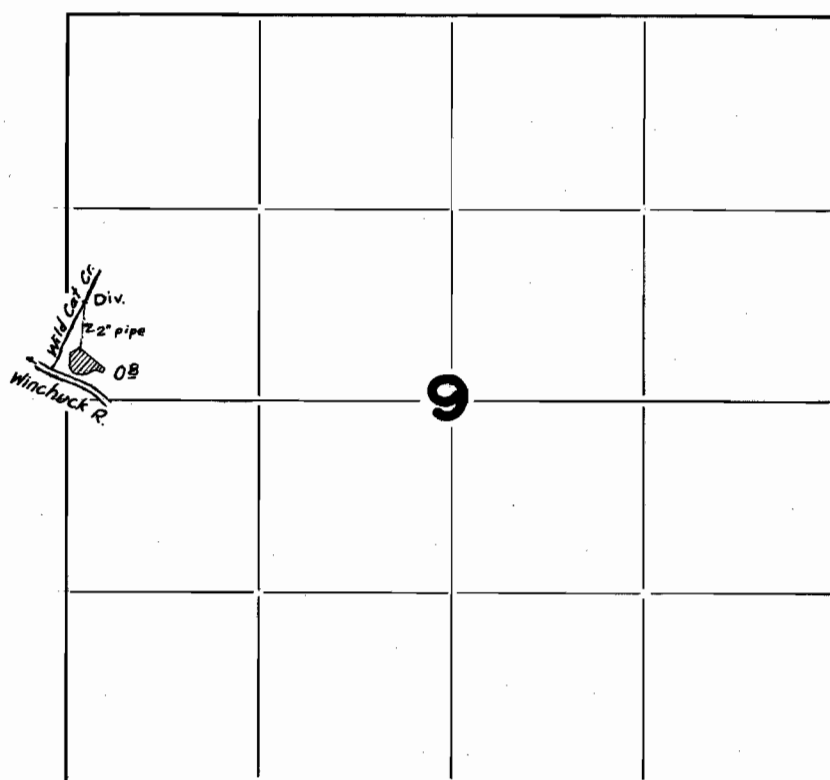

FINAL PROOF SURVEY UNDER

Application No. 16395 Permit No. 12196

IN NAME OF

J. W. Gilmore

Surveyed June 11, 1941, by C. A. Cummings

Map prepared by Geo. W. Anderson
1942