


# T. 3 S., R. 1 E. W.M.

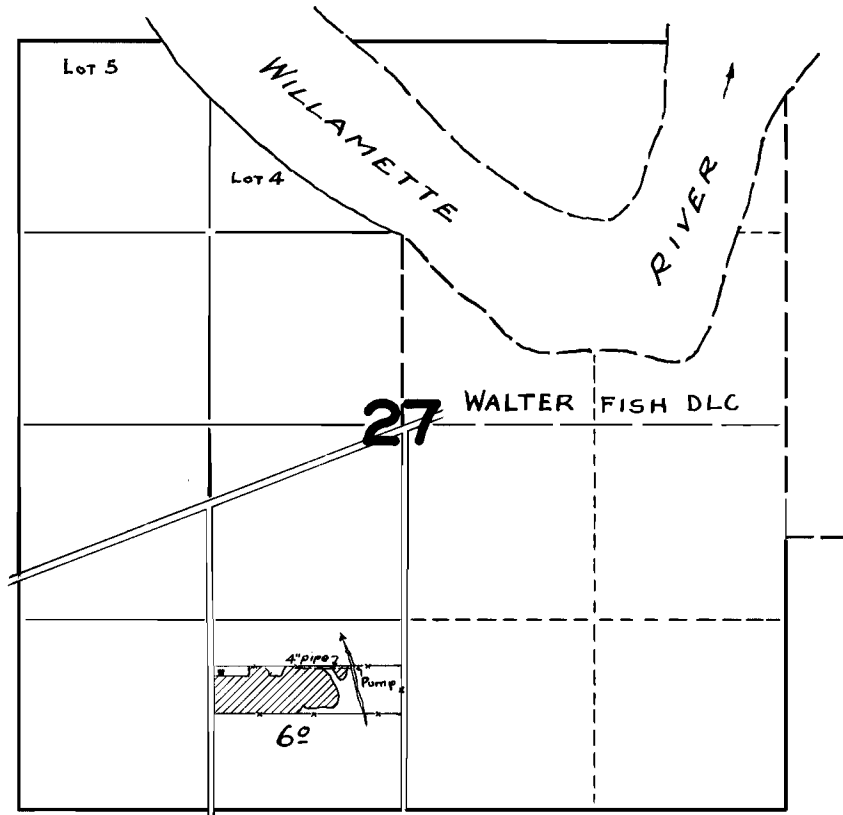

## FINAL PROOF SURVEY UNDER

Application No. 16456 Permit No. 12253

IN FAVOR OF

Fred C. & Grace Warbis

Surveyed July 21, 1942, by Geo. O. Naderman