


T. 9 S., R. 4 W. W.M.

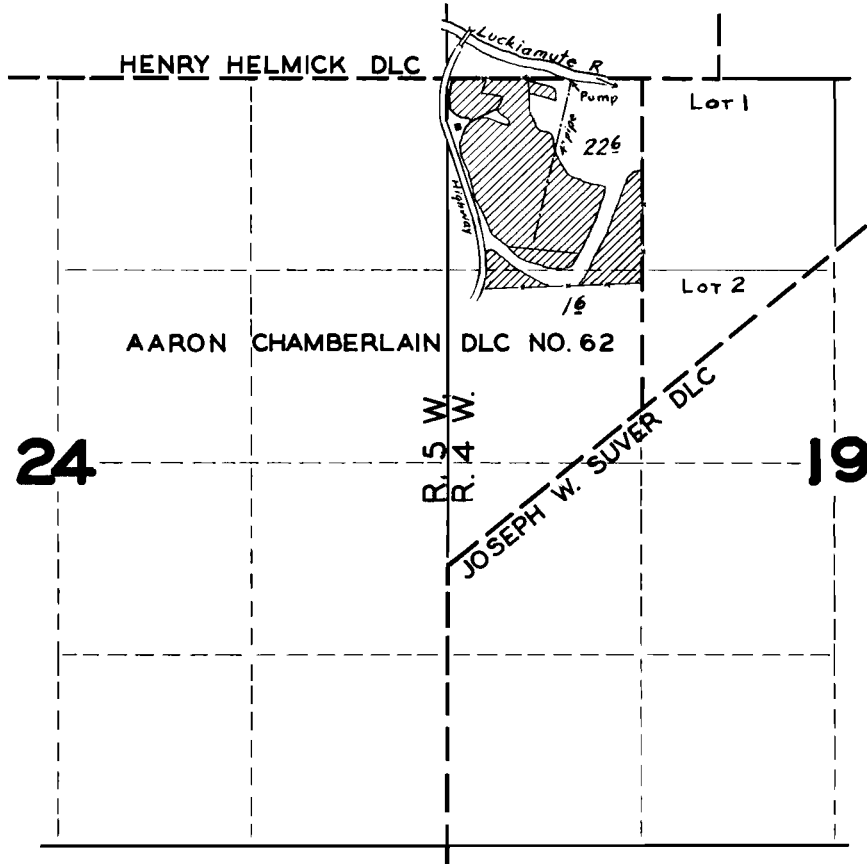

FINAL PROOF SURVEY UNDER

Application No. 16552 Permit No. 12341

IN NAME OF

Roy Miller

Surveyed June 12 1942, by Geo. V. Spederman