


TOWNSHIP 1S., RANGE 3E. W. M.

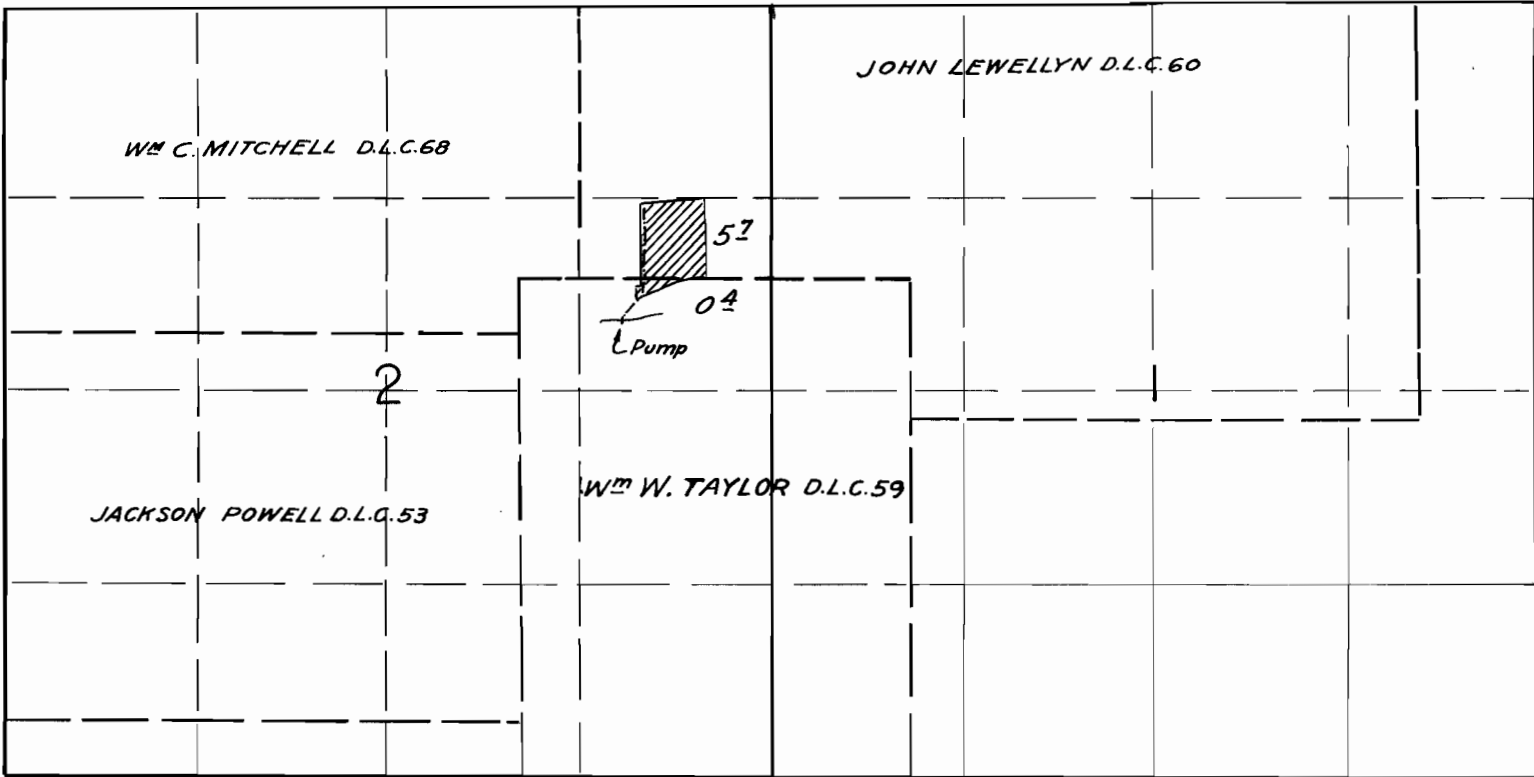

FINAL PROOF SURVEY

UNDER

Application No. 16599 Permit No. 12383

IN NAME OF

K. J. Fellman

Surveyed July 3, 1941, by Bill Summings