


T.10 S., R.10 W. W.M.

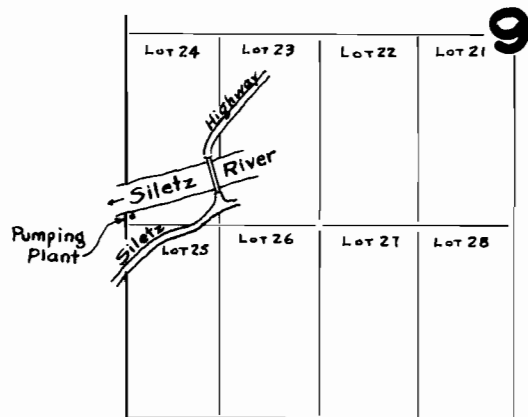

FINAL PROOF SURVEY
UNDER

Application No. 16771 Permit No. 12553

IN NAME OF

City of Toledo, Oreg.

Surveyed Sept 11, 1942, by Geo. J. Maderman