


T. 2 S., R. 4^{AND} 5 W. W.M.

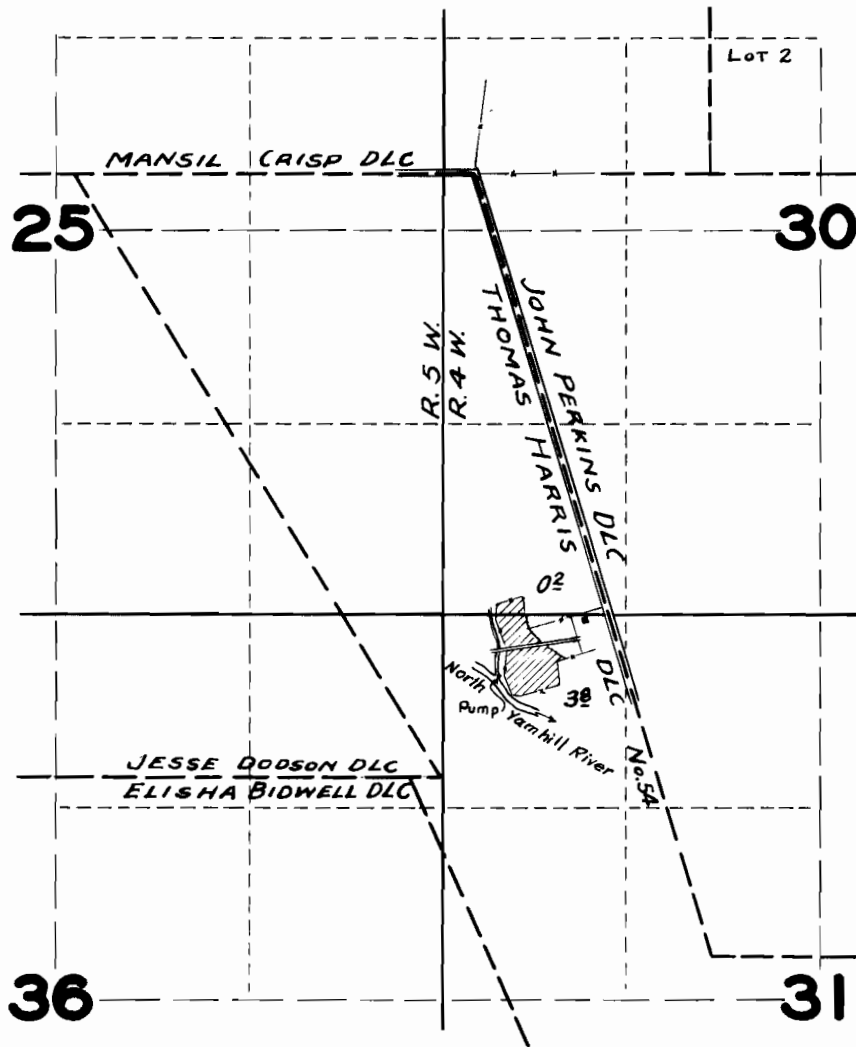

FINAL PROOF SURVEY
UNDER

Application No. 16808 Permit No. 12576

IN NAME OF

Mrs. Fannie Robertson

Surveyed Aug. 13 1942, by Geo. Pederman