


TOWNSHIP 39 S. RANGE 15E.

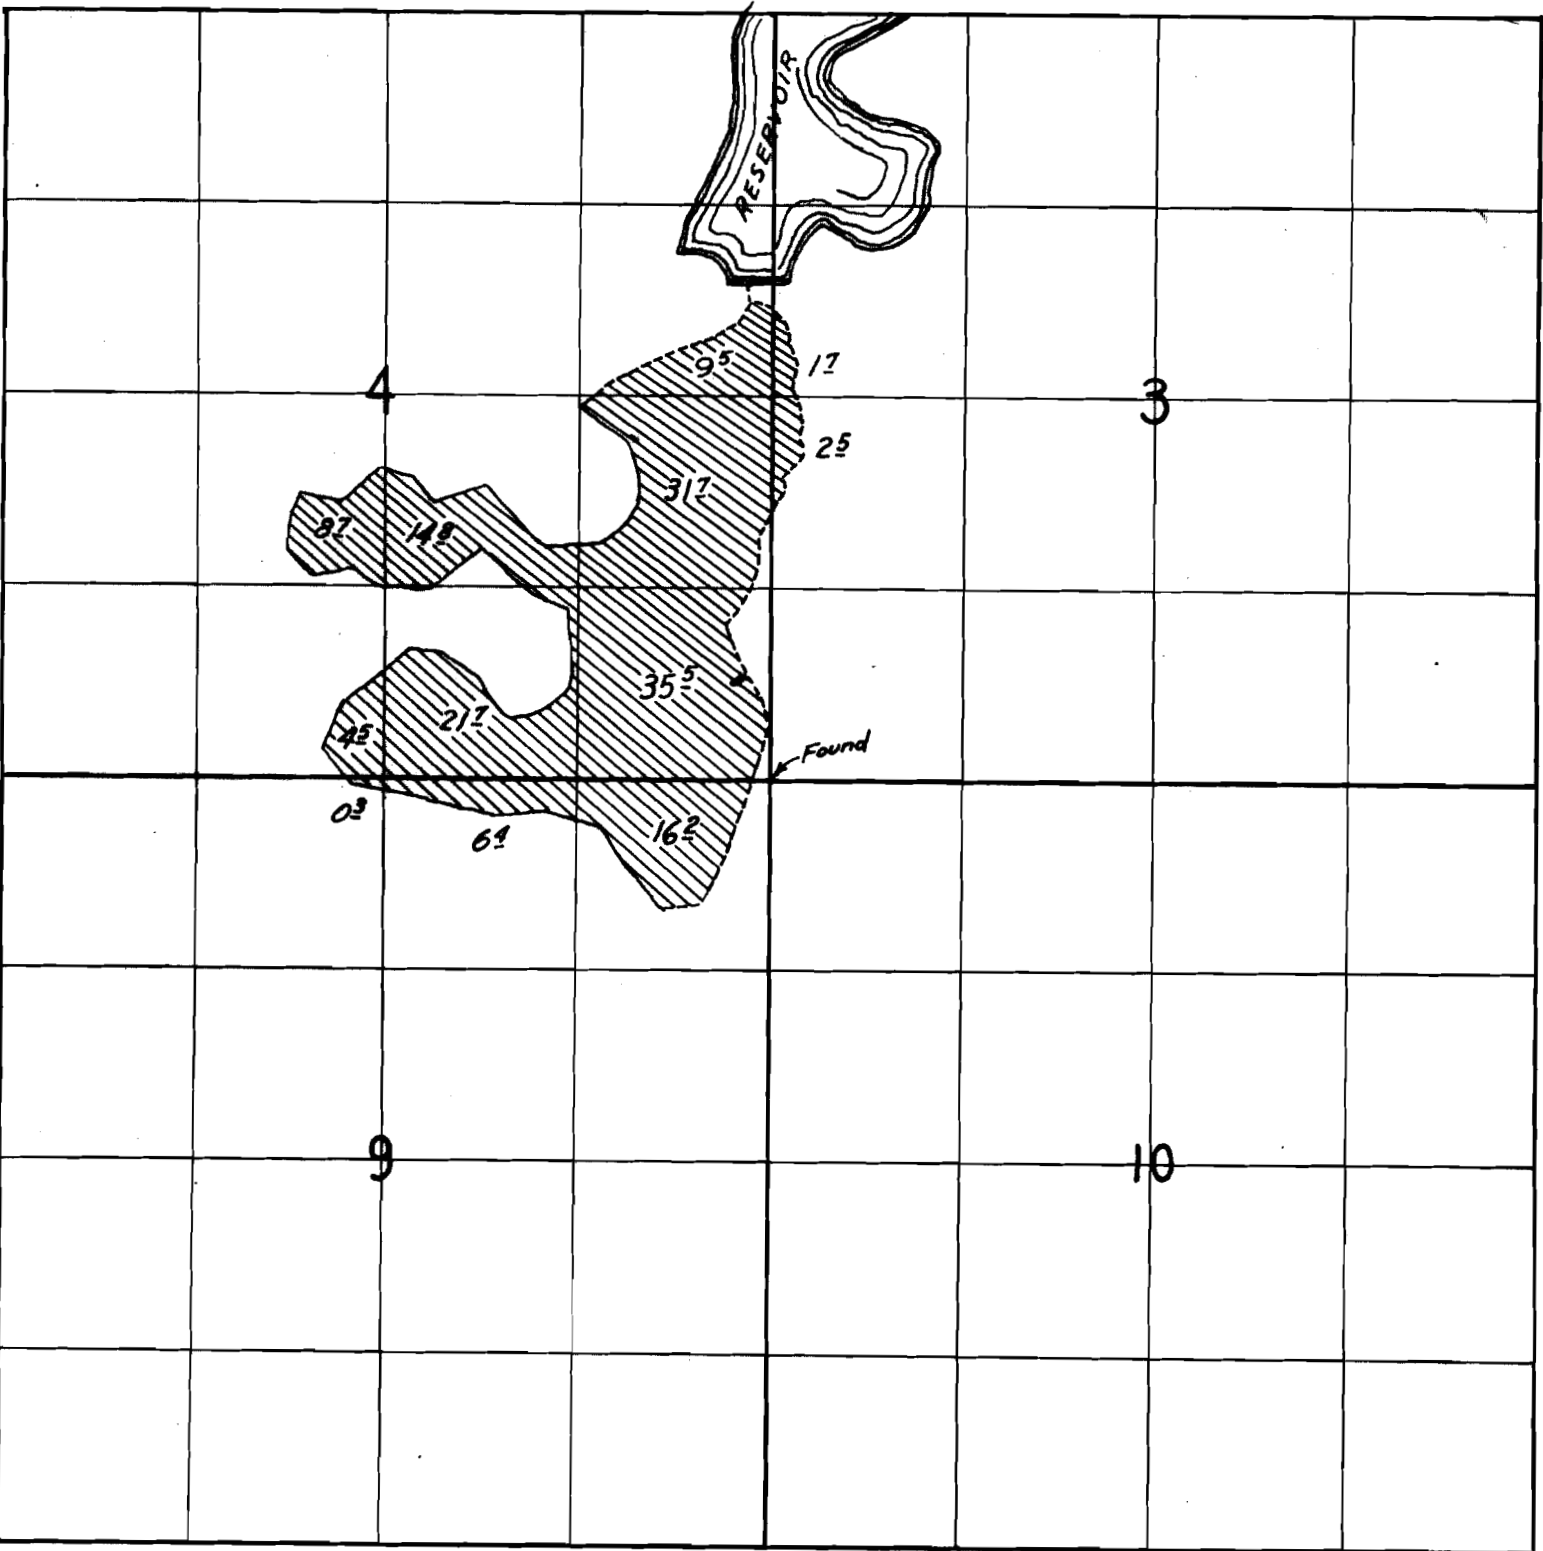

FINAL PROOF SURVEY
UNDER

Application No. 16779 Permit No. 12649

IN NAME OF

Lloyd Gift

Surveyed July 20 1941, by Charles Cummins