


T. 11 S., R. 7 W. W.M.

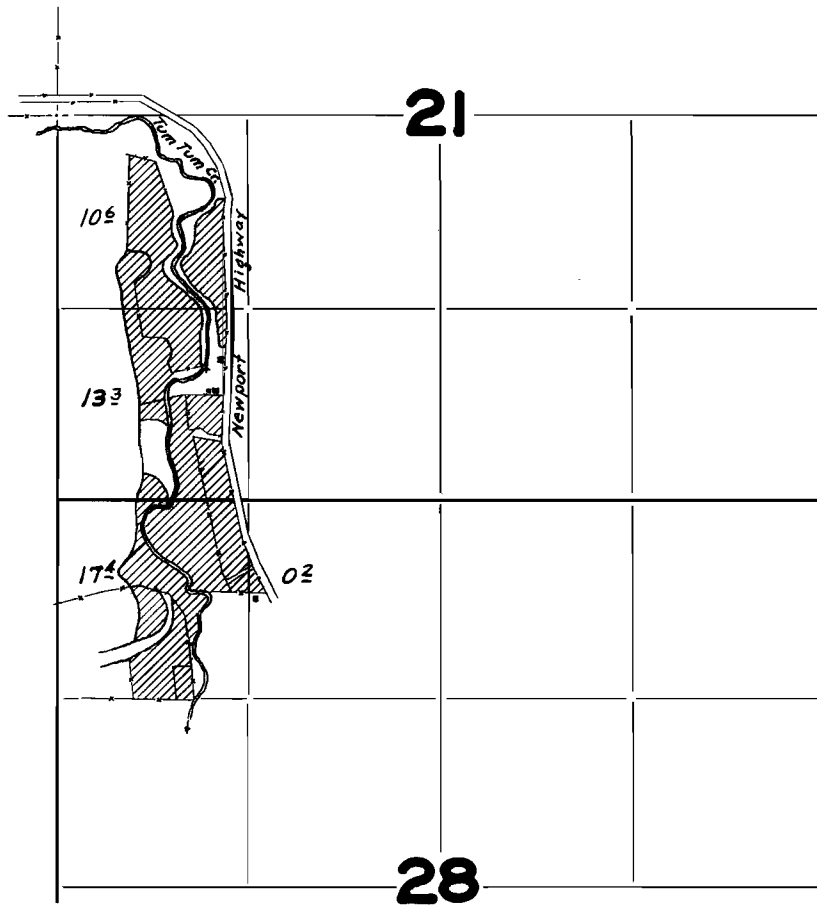

FINAL PROOF SURVEY
UNDER

Application No. 16896 Permit No. 12658

IN NAME OF

Elmo A. Wehnert

Surveyed Sept. 1, 1942, by Geo. W. Pademan