




, Range 27 E.W.M..

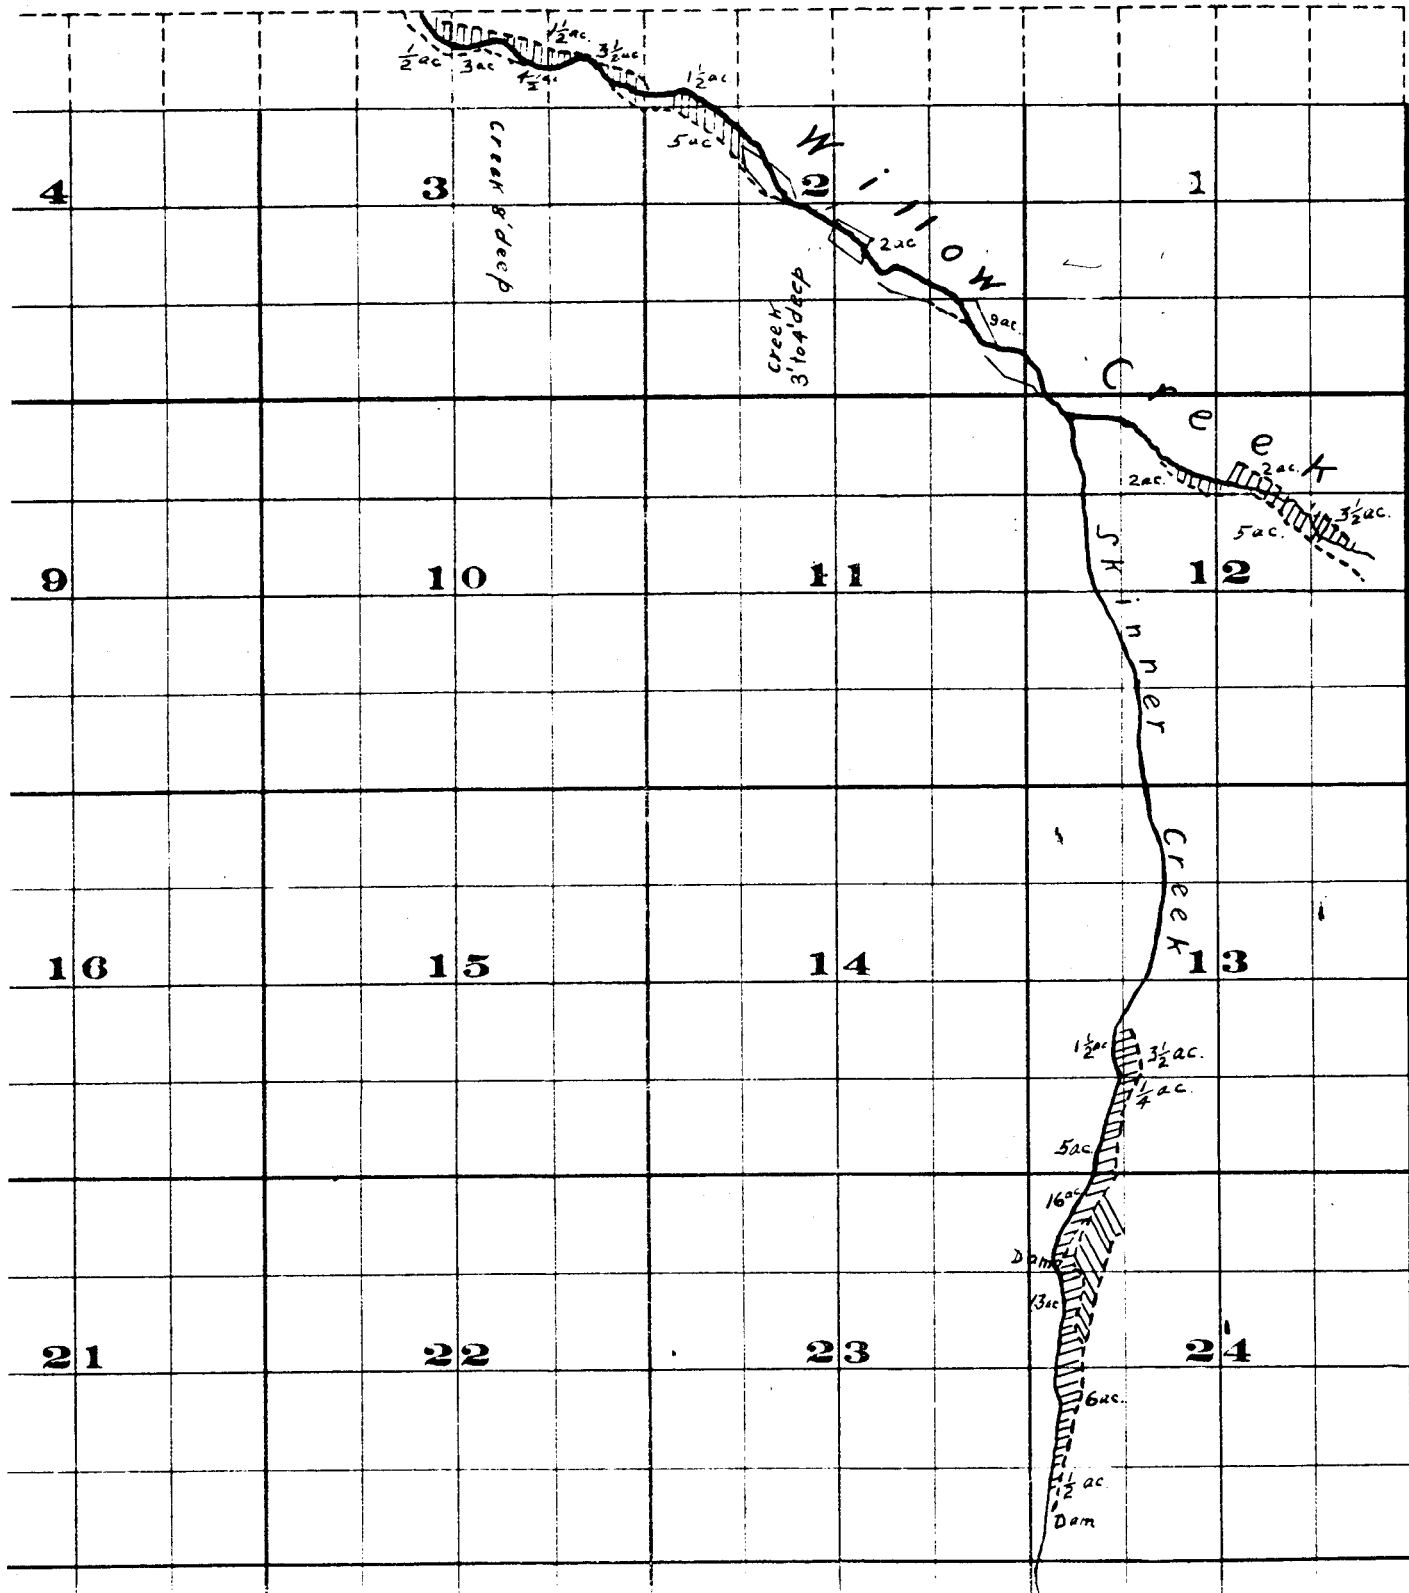


Township 35

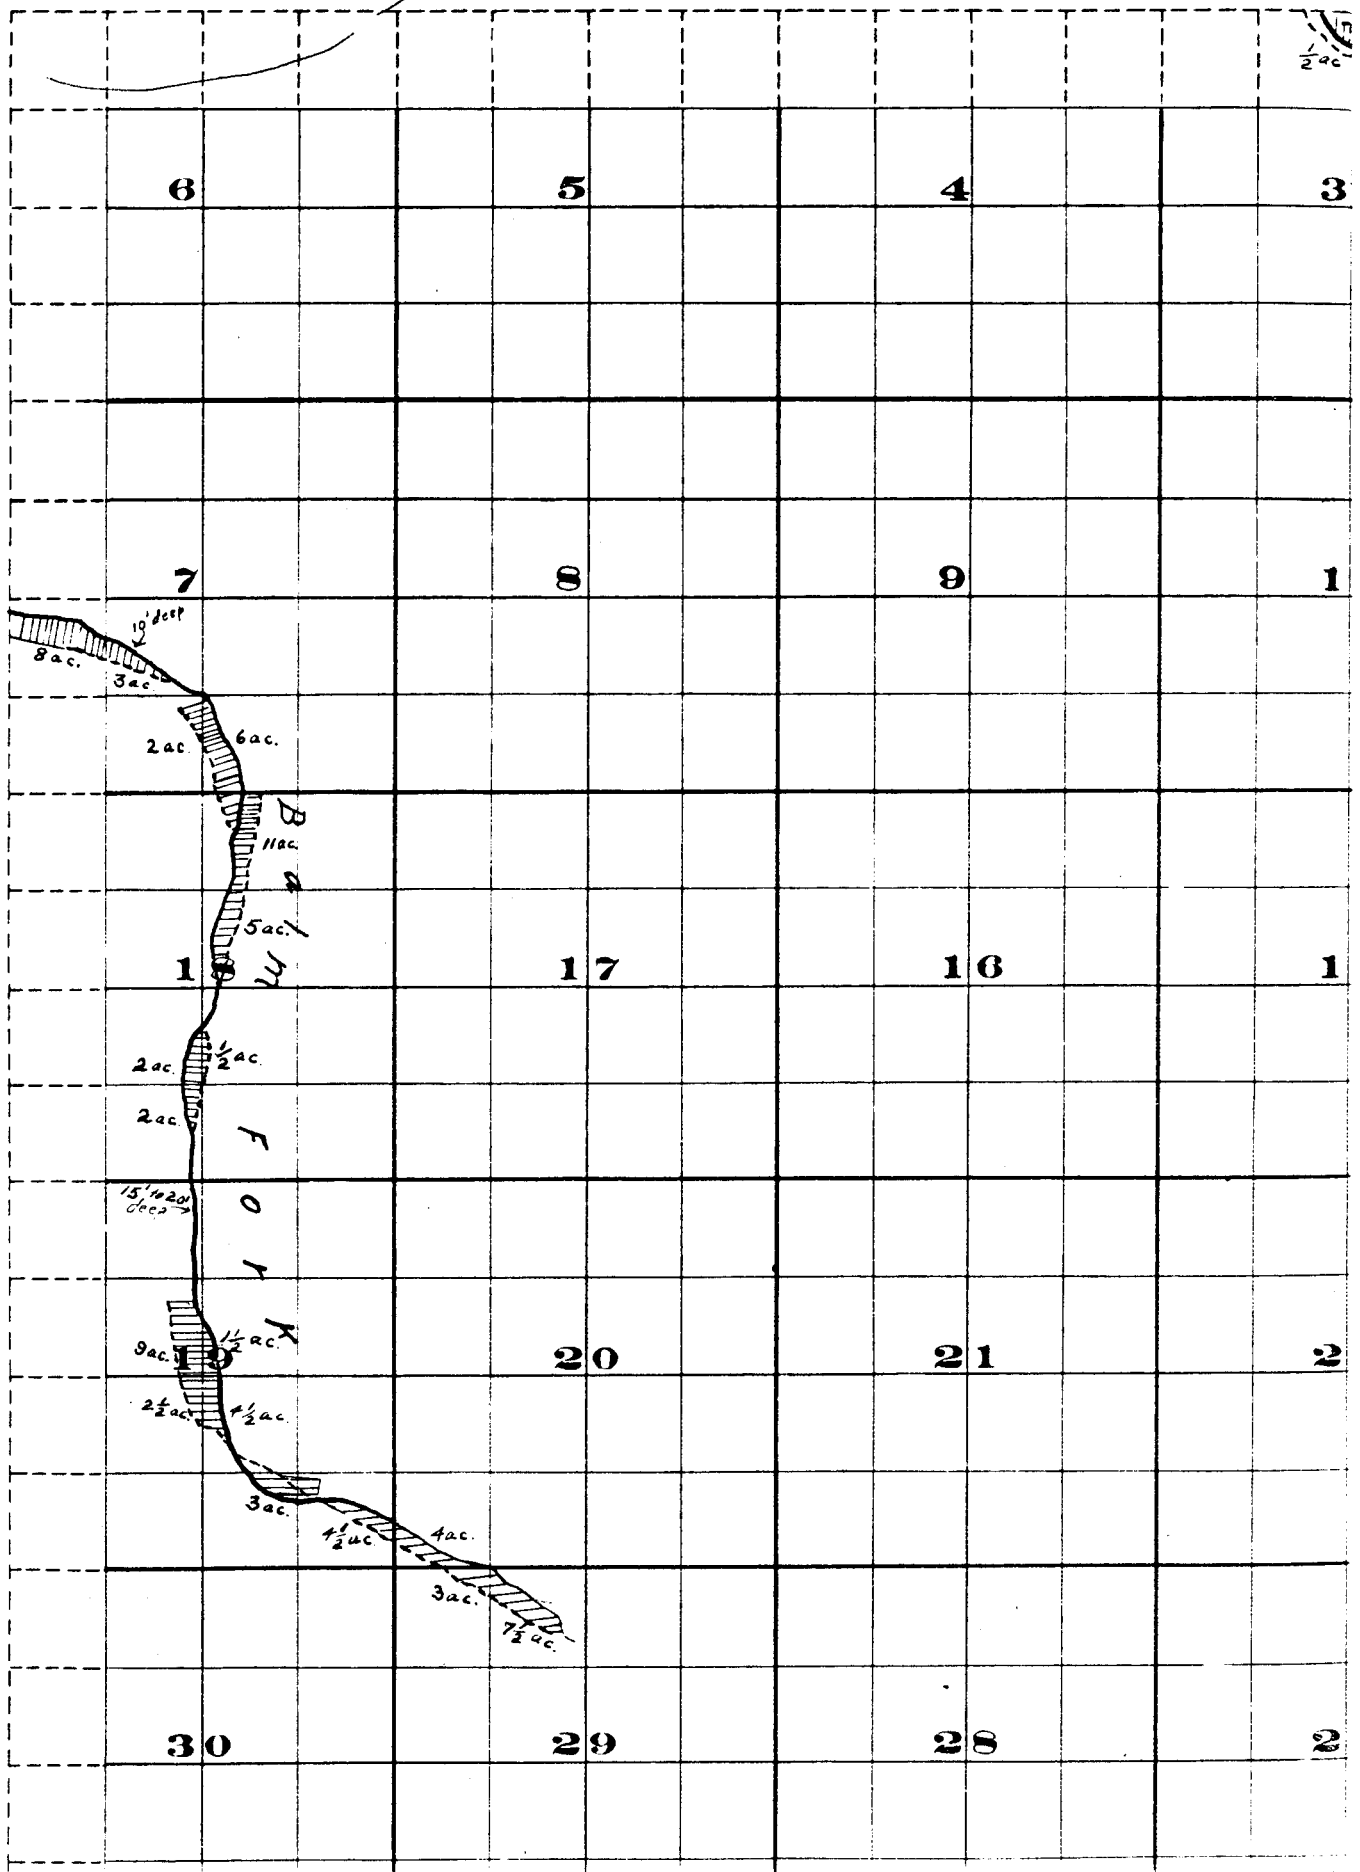

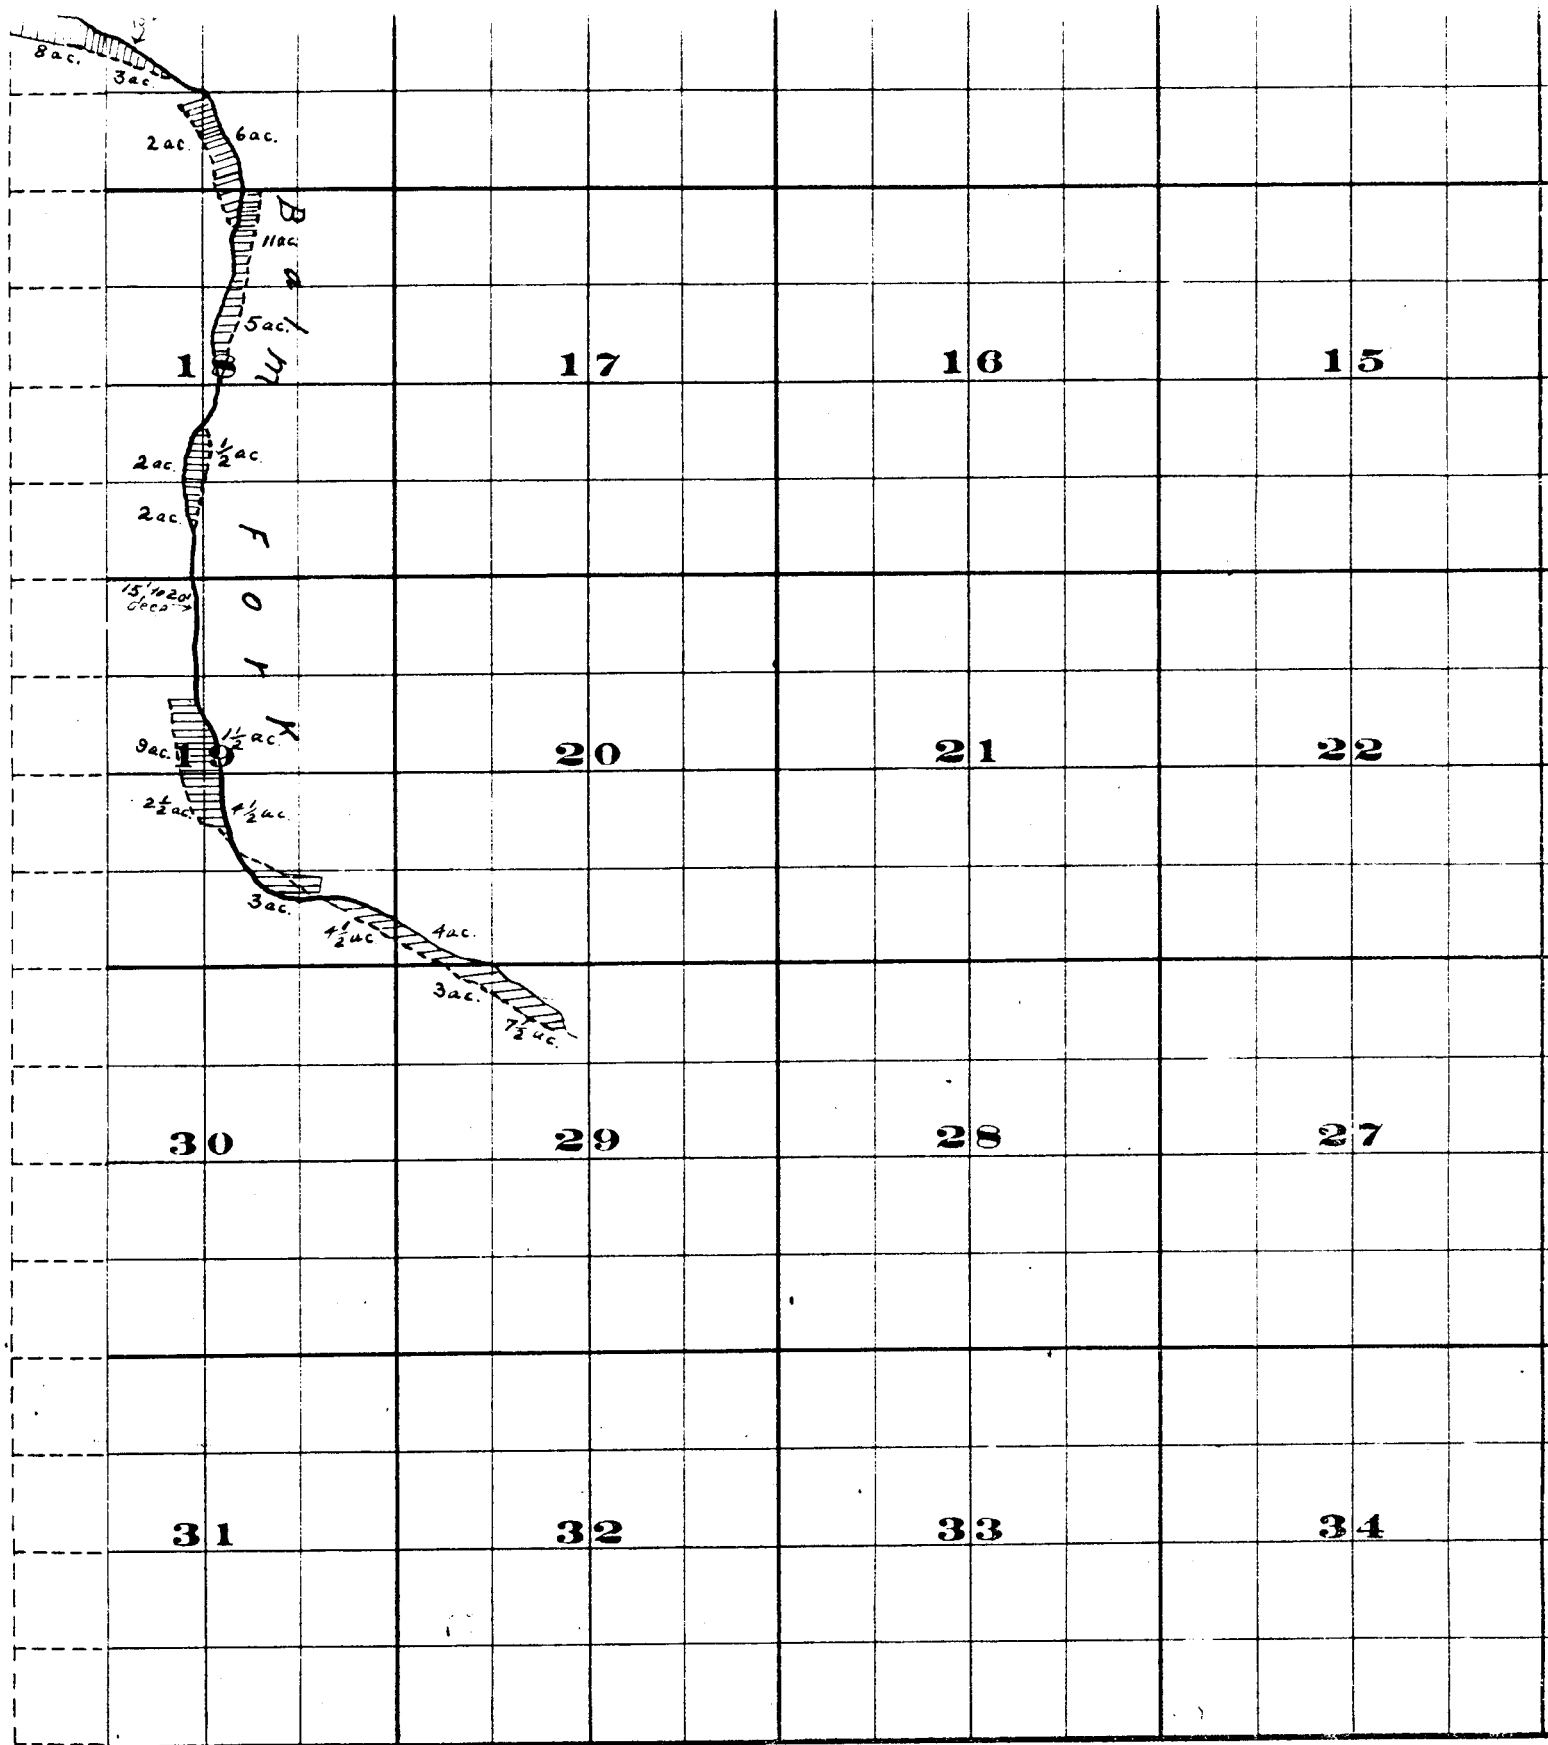

THE S. A. BRISTOL CO. PRINTERS & BOOKBINDERS CHICAGO, ILL.

Surveyed by H.K. Donnelly July 1909
 Surveyed by R.D. Cooper July 1909
 John H. Lewis - State Engineer
 Examined, July 14, 1909.

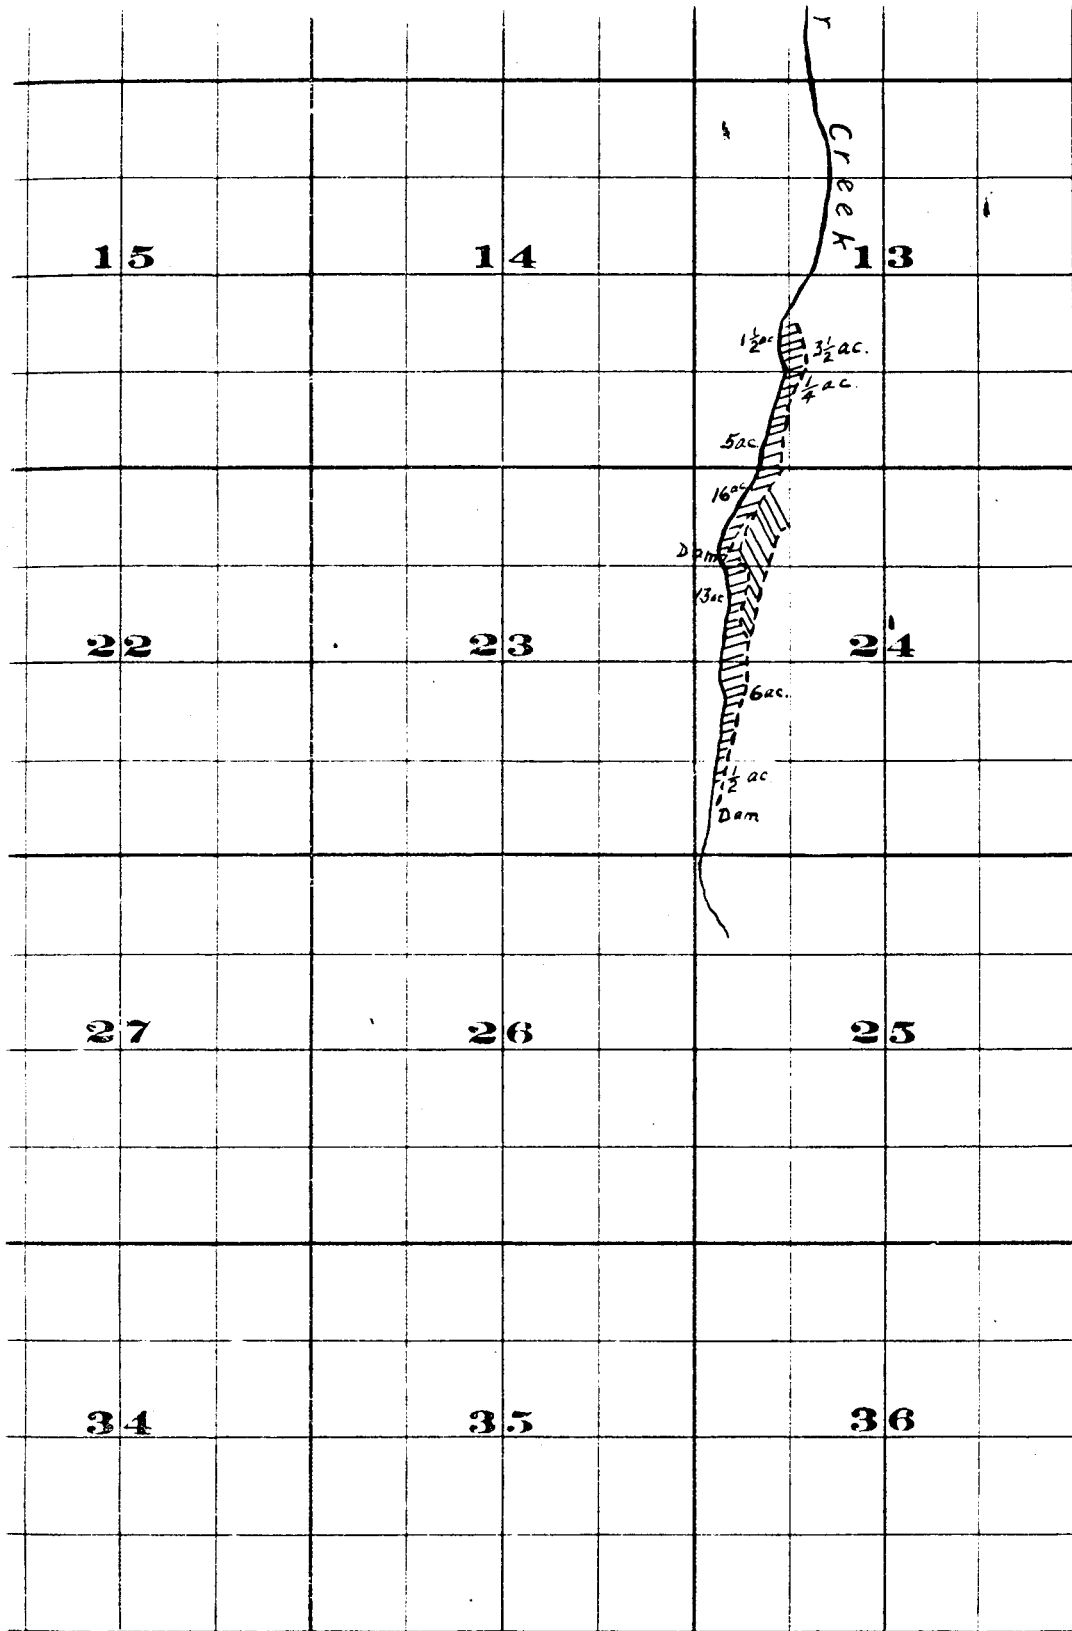

FROM OFFICE OF THE STATE ENGINEER, SALEM, OREGON
Willow Creek Adjudication

35.27 E.