


T. 3 S., R. 1 E. W.M.

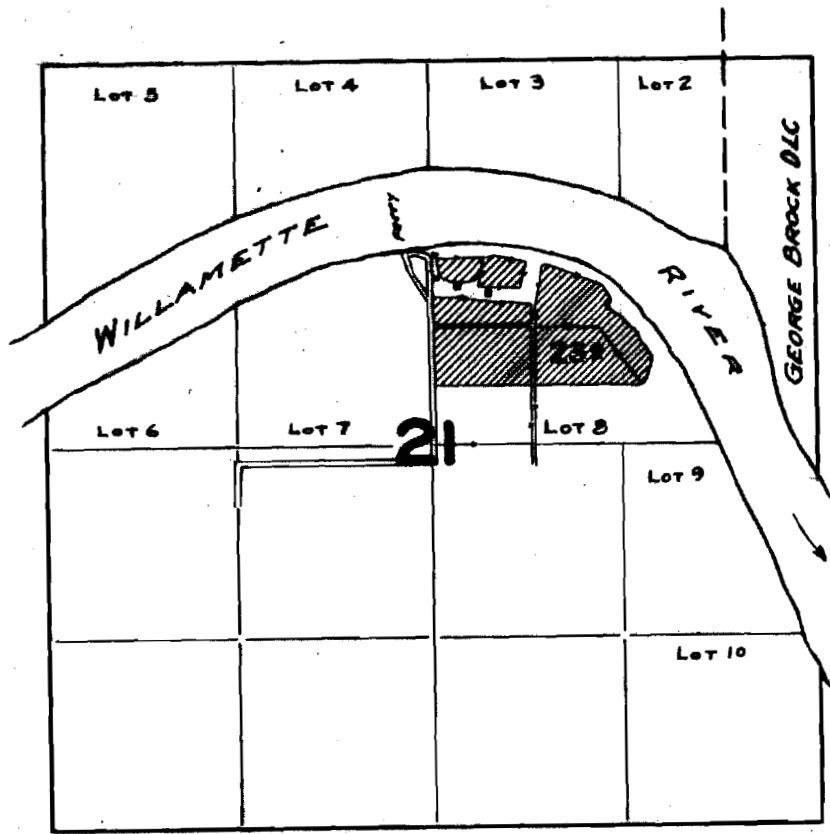

FINAL PROOF SURVEY UNDER

Application No. 16923 Permit No. 12680

IN FAVOR OF

J. L. Tretheway

Surveyed July 21, 1942, by Geo. W. Anderson