


SECTI

TOWNSHIP 65, RANGE 5W., W. M.

North

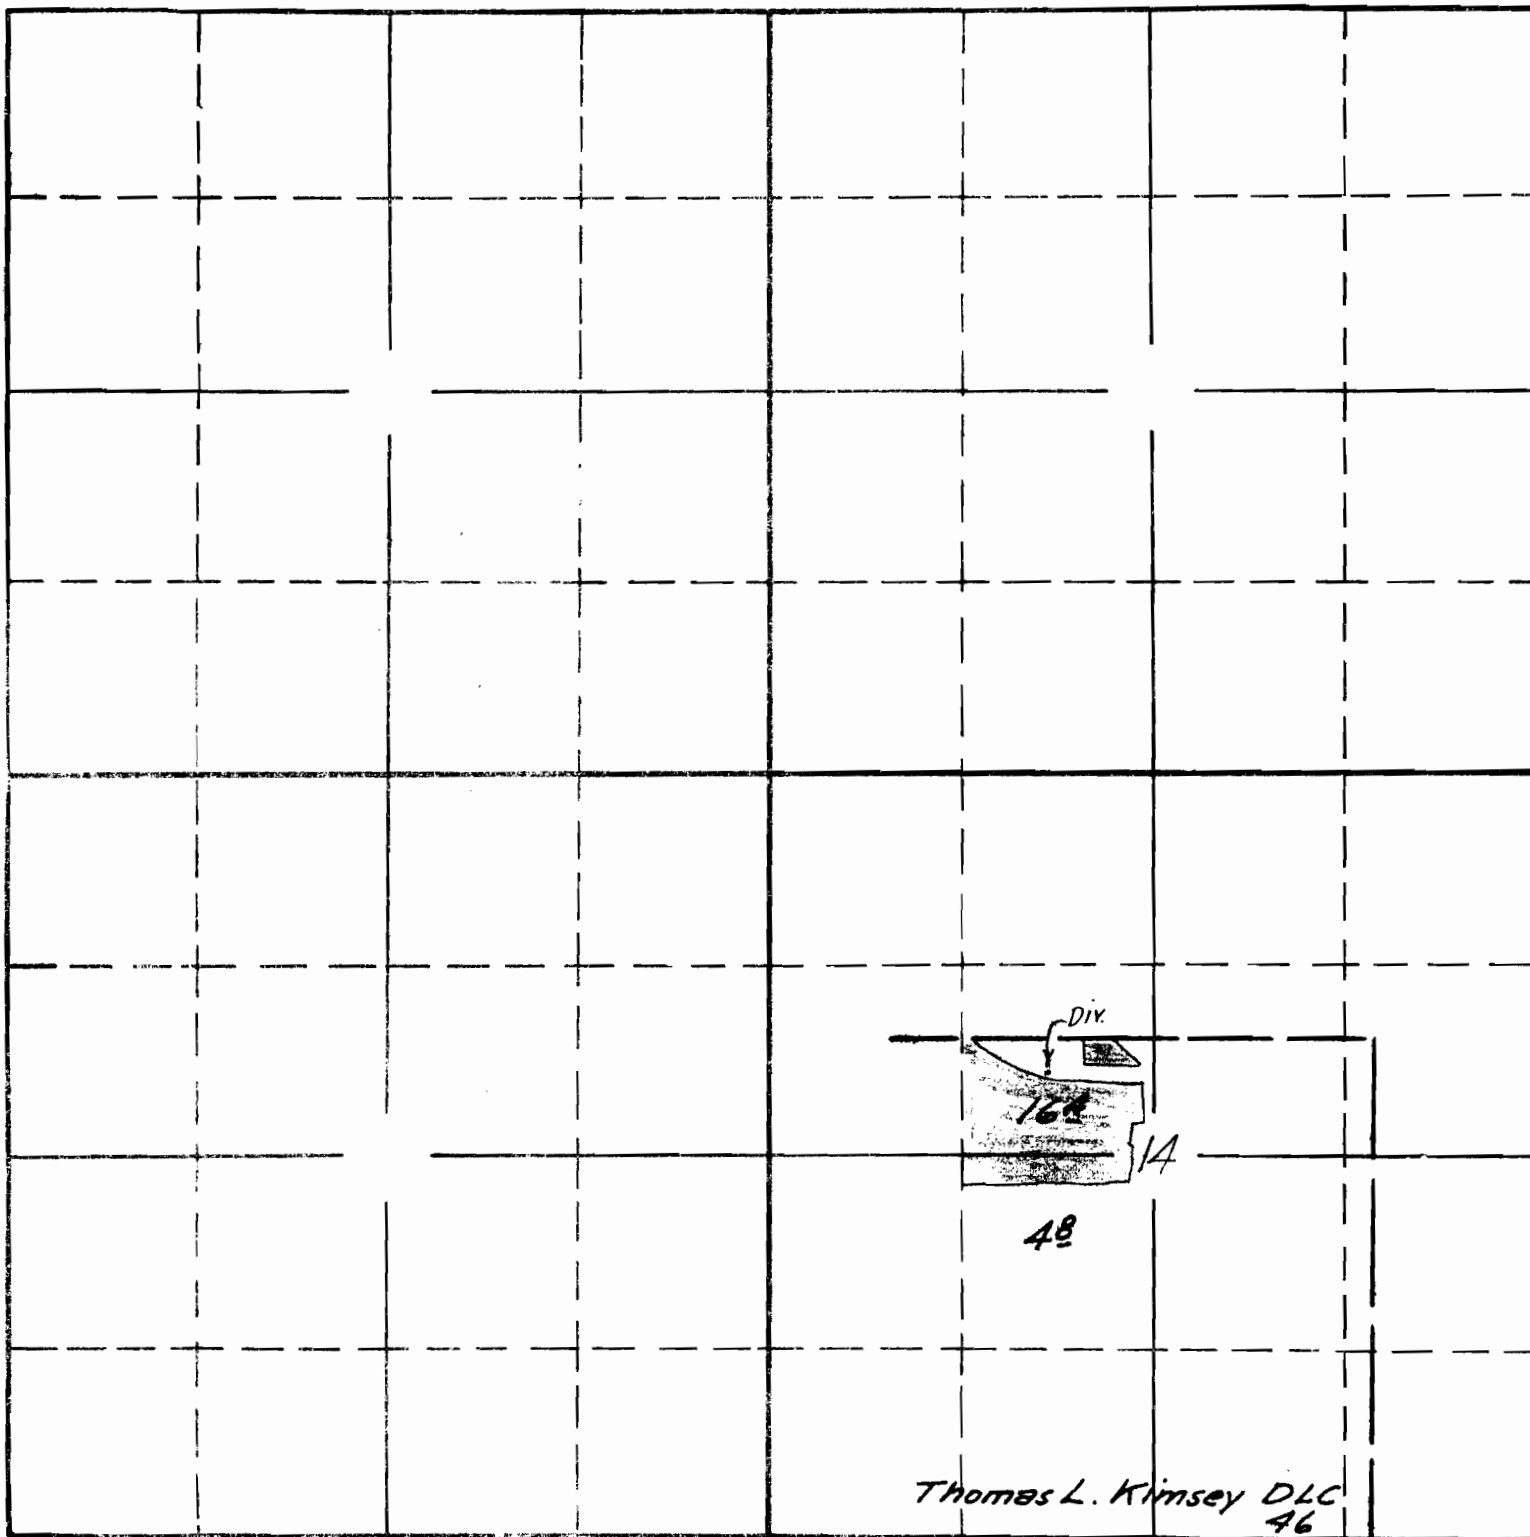

Thomas L. Kimsey DLC  
46

Surveyed June 1 1940 C.A.C.

South

APPLICATION No. 16938

PERMIT No. 12688

SECTION


14

TOWNSHIP 6S., RANGE 5W., W. M.

North

West

East

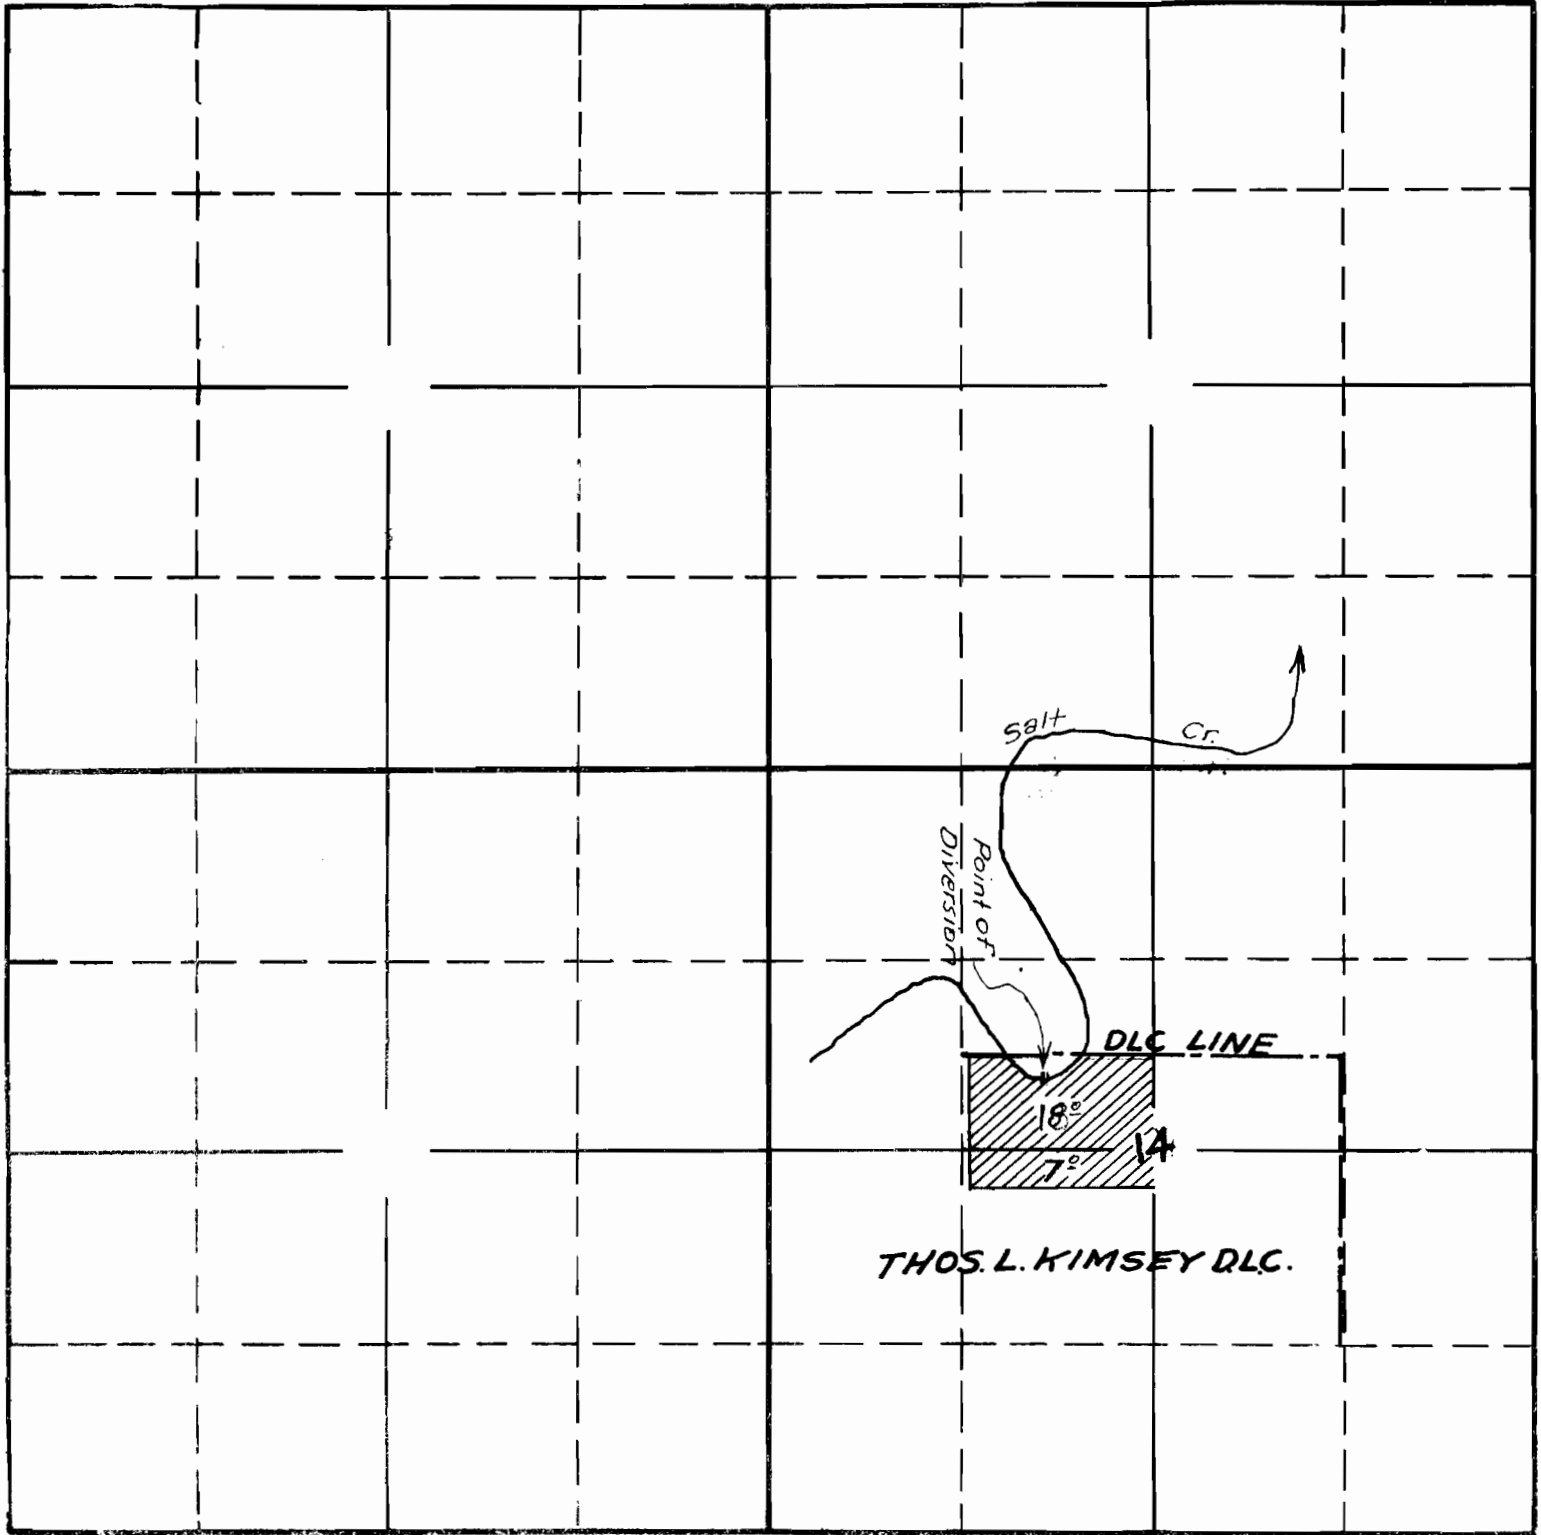

South

2-90B-16938  
 APPLICATION No. 16938  
 PERMIT No. 12688