


T. 6 S., R. 3 E. W.M.

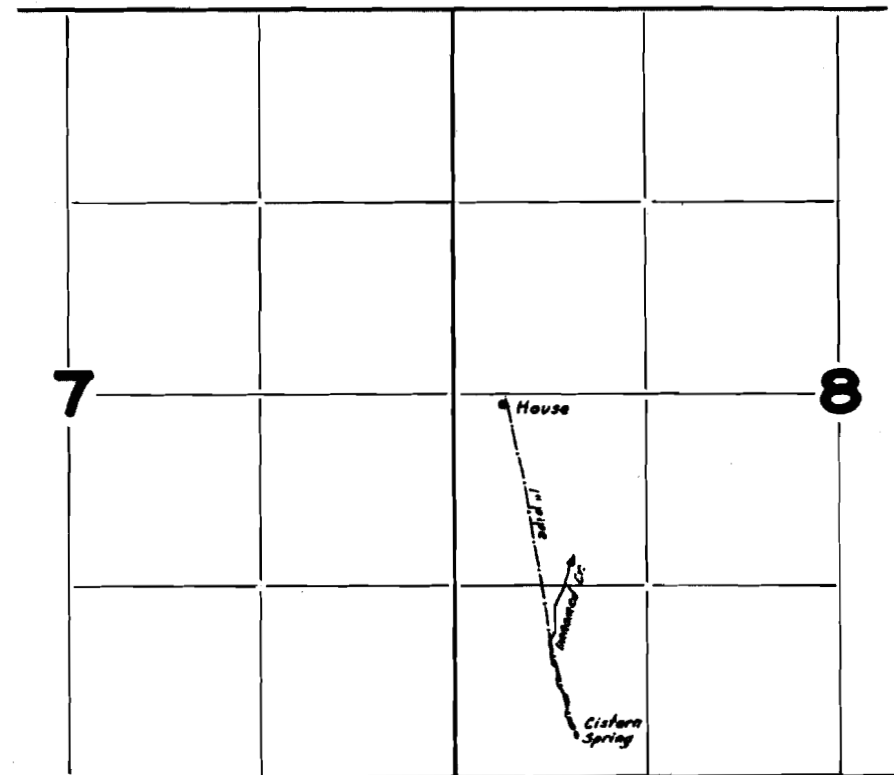

**FINAL PROOF SURVEY
UNDER**

Application No. 16966 Permit No. 12720

IN NAME OF

Clement S. Woodward

Surveyed July 22 1942, by E. J. Anderson