


# T. 7 S., R. 5 W. W.M.

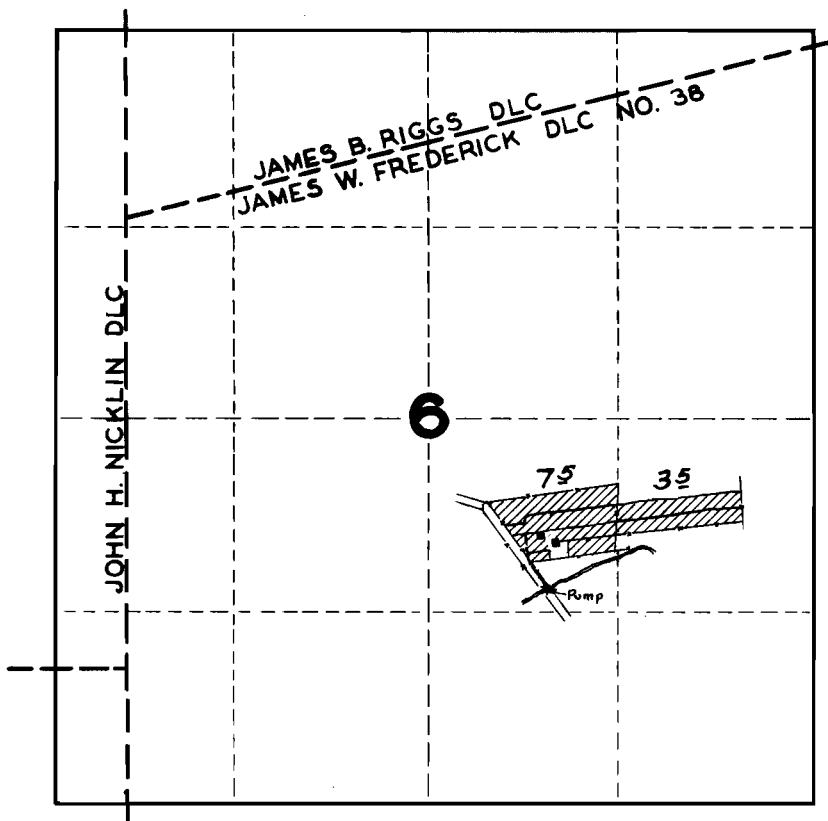

## FINAL PROOF SURVEY UNDER

Application No. 17059 Permit No. 12798

IN FAVOR OF

W. G. Reddekopp

Surveyed June 9, 1942, by Geo. W. Faderman