


T.10 S., R.11 W. W.M.

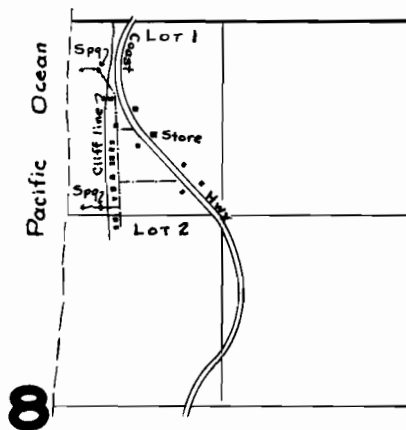

FINAL PROOF SURVEY
UNDER

Application No. 17070 Permit No. 12803

IN NAME OF

W. K. Deal

Surveyed Sept. 11, 1942, by Geol. Naderman