


T. I S., R. I E. W.M.

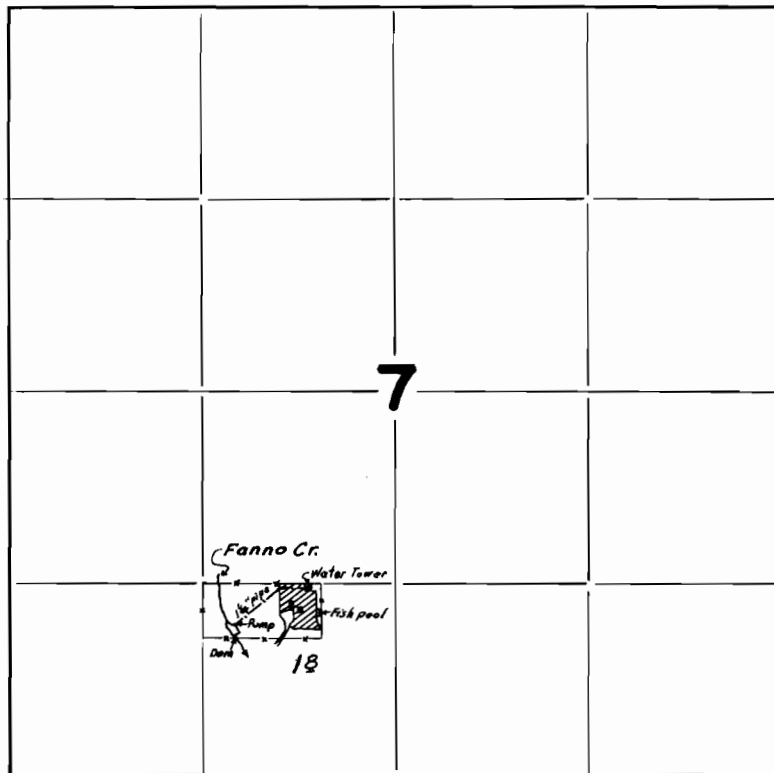

FINAL PROOF SURVEY UNDER

Application No. 17080 Permit No. 12811

IN FAVOR OF

George E. Linton

Surveyed July 30 1942, by Carl Maderman