


T. 15 S., R. 6 W. W.M.

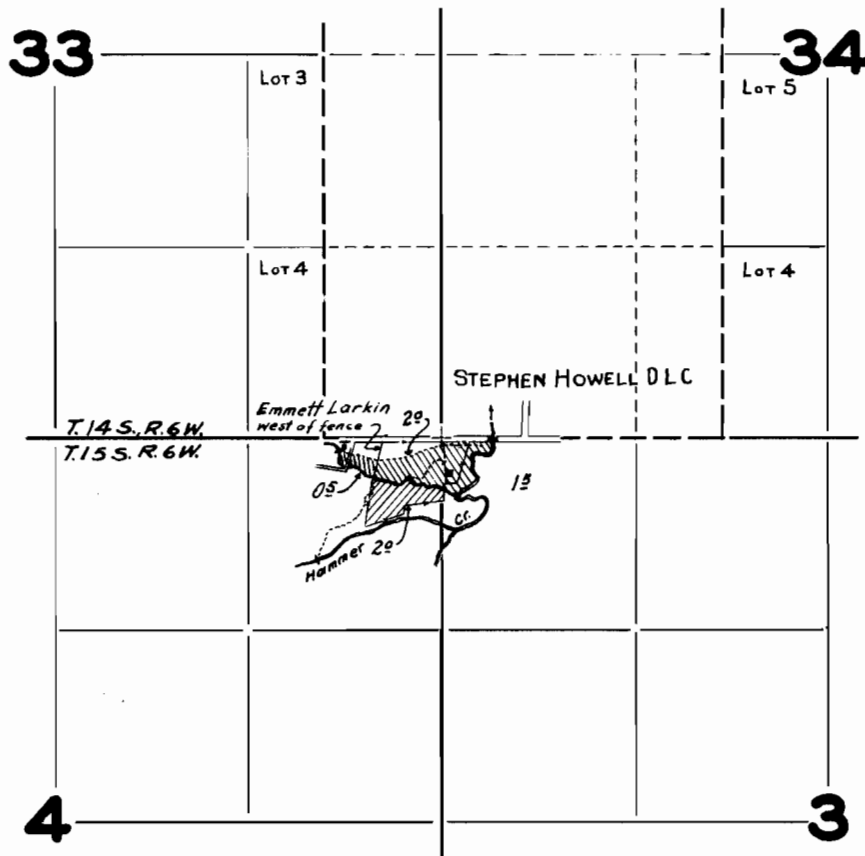

FINAL PROOF SURVEY UNDER

Application No. 17061 Permit No. 12831

IN NAME OF

E. P. Larkin

Surveyed Sept. 3 1942, by Geor. Spademan