


# T. 2 N., R. 3 W. W.M.

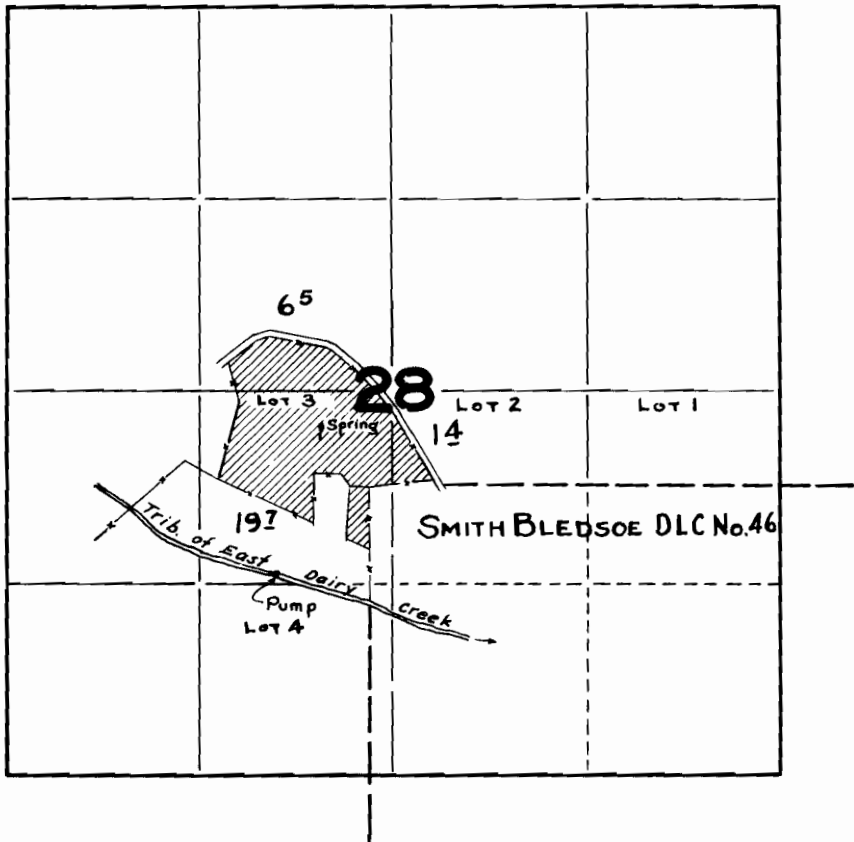

## FINAL PROOF SURVEY

UNDER

Application No. 17136 Permit No. 12870

IN FAVOR OF

W. S. Hahn

Surveyed Oct. 14, 1937, by C. A. Cummings

Map prepared by Geo. T. Adelman