


T. 3 S., R. 9 W. W.M.

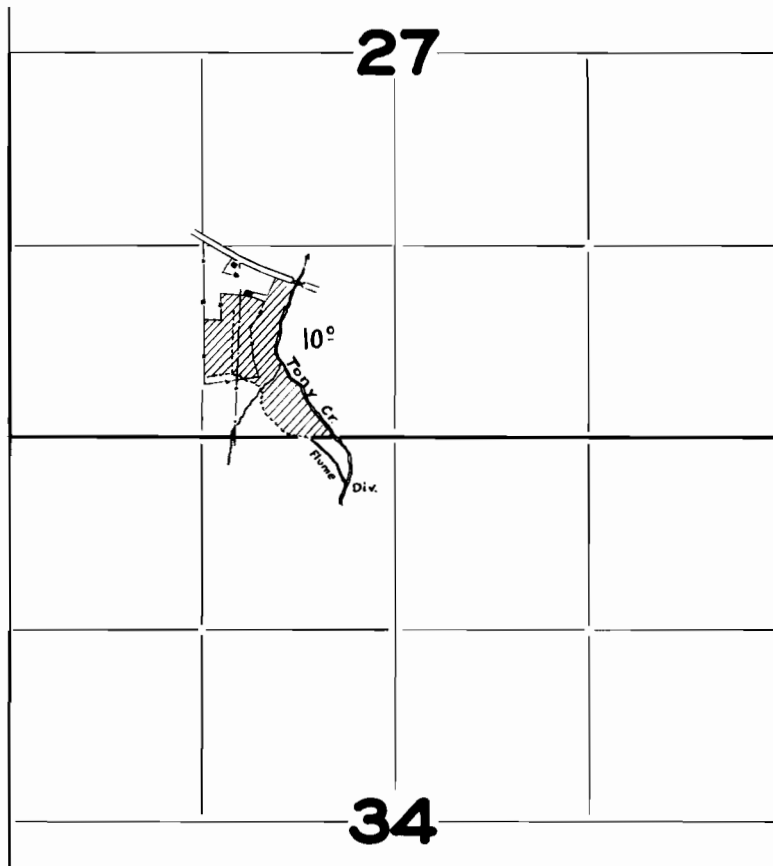

FINAL PROOF SURVEY

UNDER

Application No. 17243 Permit No. 12954

IN NAME OF

Elmer R. Lewis

Surveyed Aug 21, 1942, by Geoff Pedersen