


TOWNSHIP 15 S., RANGE 4 W.

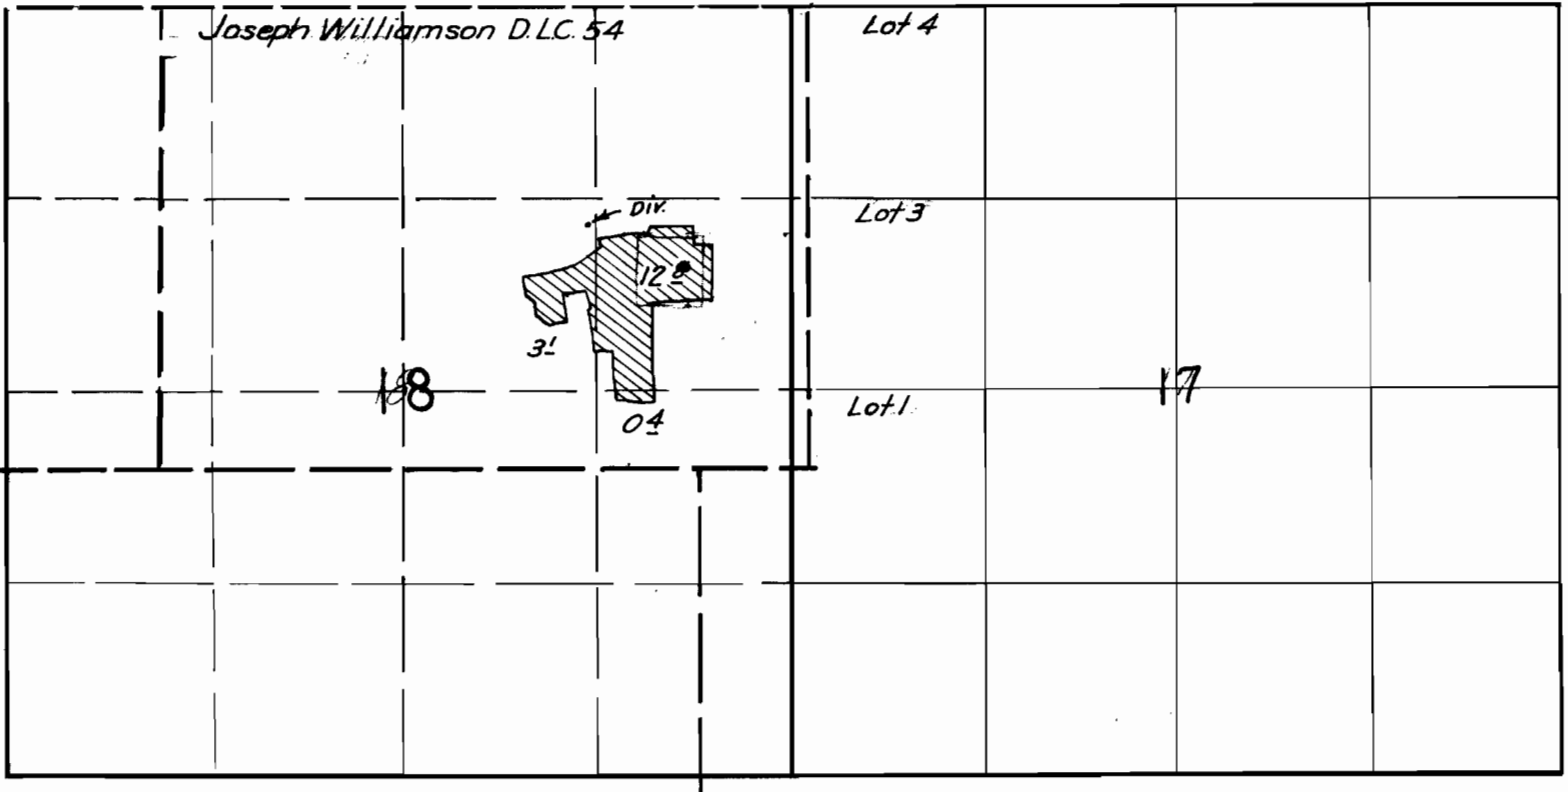

FINAL PROOF SURVEY
UNDER

Application No. 17294 Permit No. 13000

IN NAME OF

Howard Lynch

Surveyed May 21, 1941, by C. H. Williams