


T. 4 S., R. 3 E. W.M.

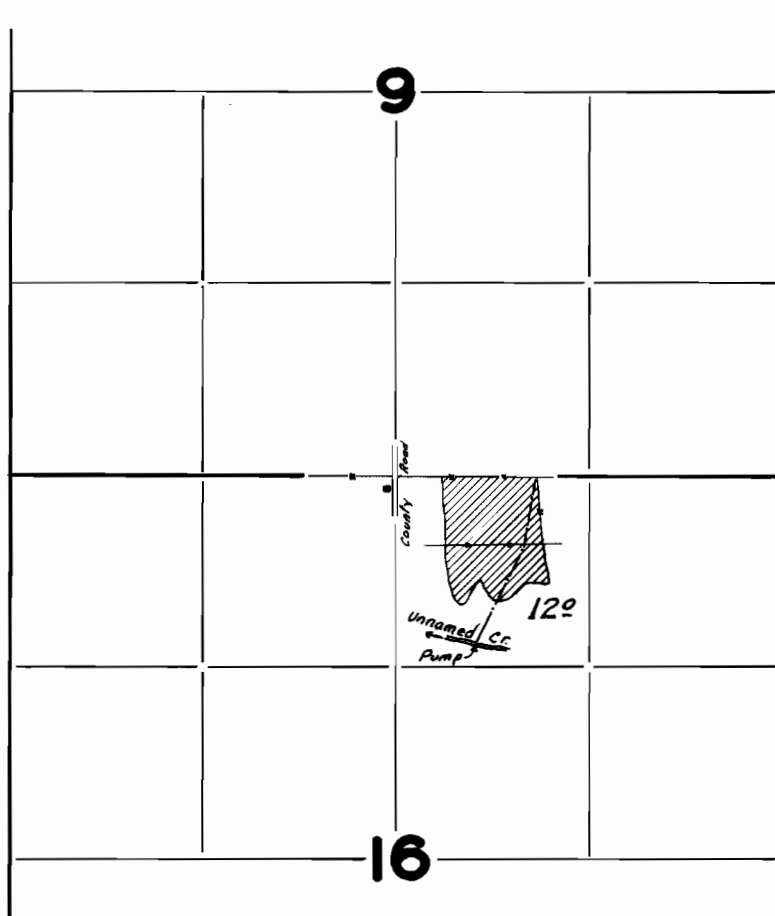

FINAL PROOF SURVEY
UNDER

Application No. 17304 Permit No. 13004

IN NAME OF

Lewis Nielsen

Surveyed July 23, 1942, by Scott Aderman