
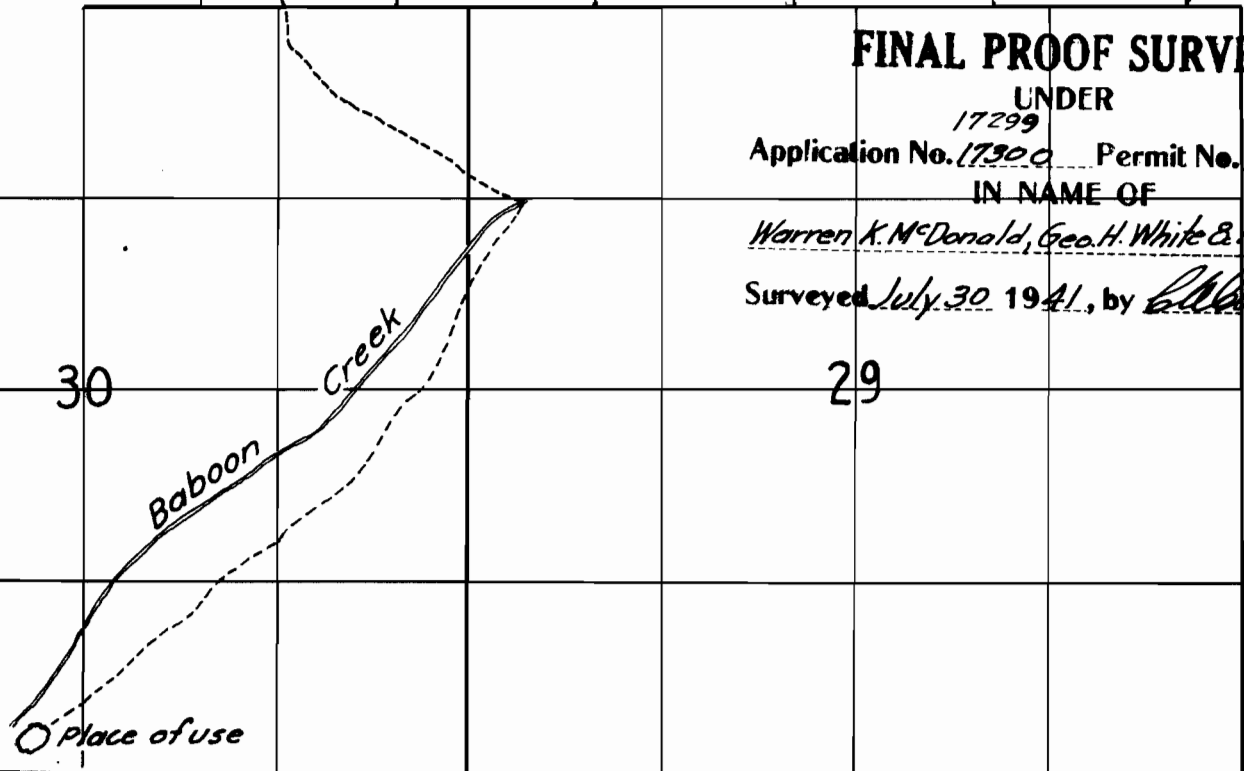


TOWNSHIP 9S., RANGE 38E.

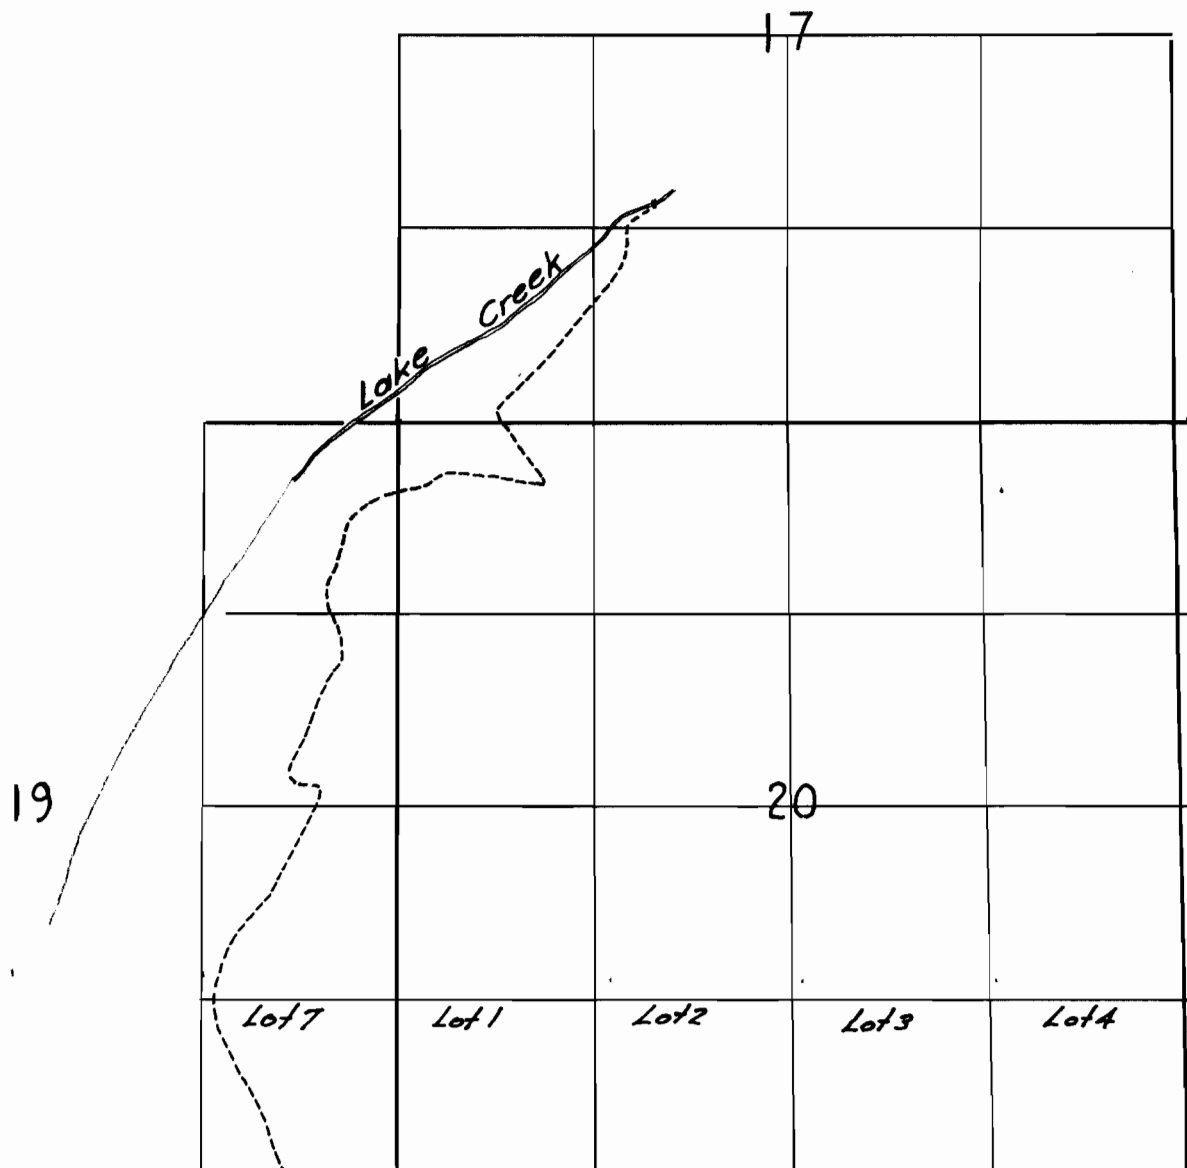

FINAL PROOF SURVEY

UNDER
17299
Application No. 17300 Permit No. 13012
13013
IN NAME OF
Warren K. McDonald, Geo. H. White & Fred Muller
Surveyed July 30 1941, by *Ed. Cummings*

29