
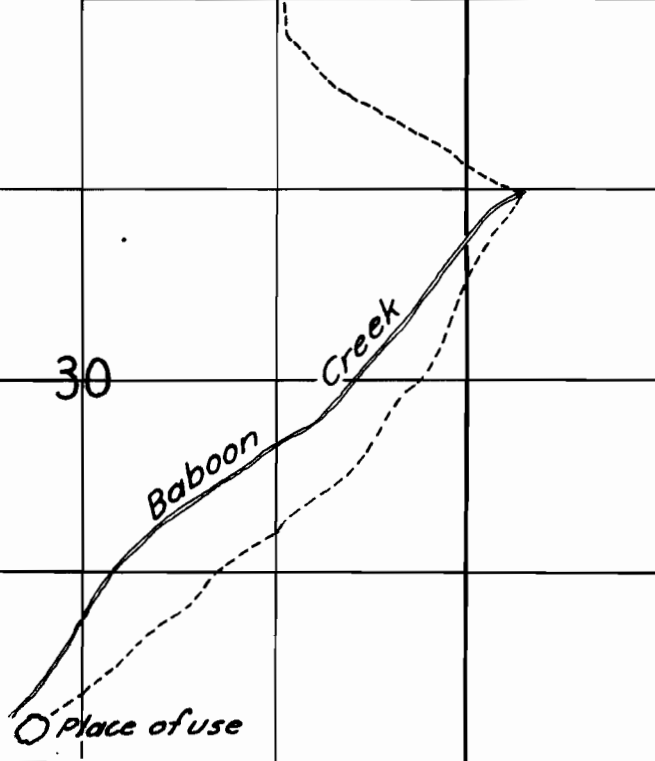


TOWNSHIP 9S., RANGE 38E.

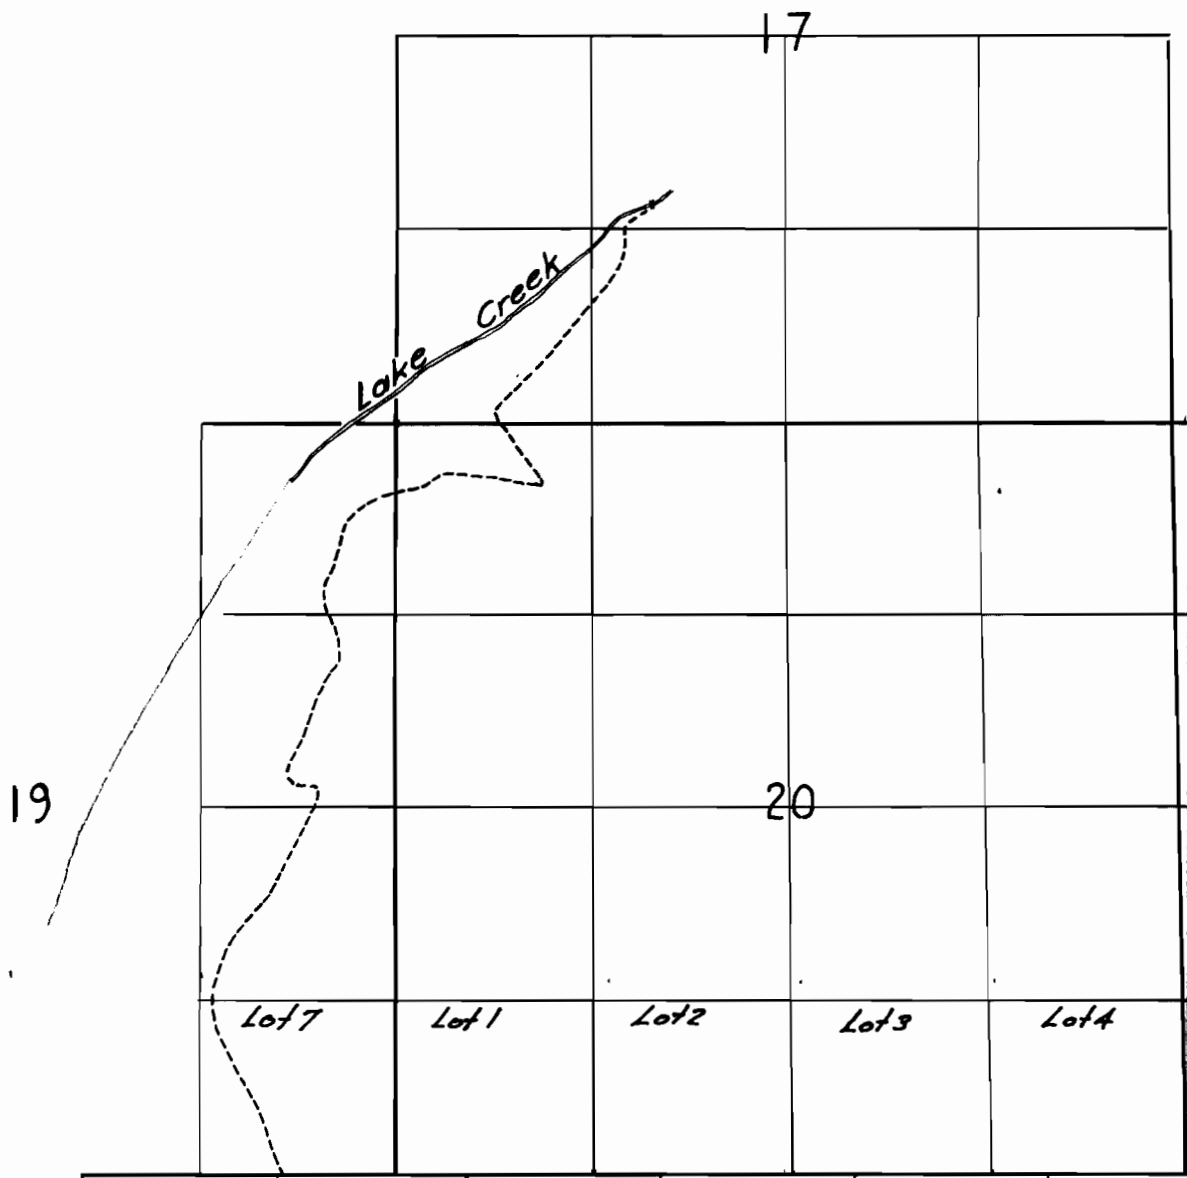

FINAL PROOF SURVEY

UNDER

17299

13012

Application No. 17300

Permit No.

13013

IN NAME OF

Warren K. McDonald, Geo. H. White & Fred Muller

Surveyed July 30 1941, by *Ed. Cummings*

29

30