


T. 2 S., R. 1 E. W.M.

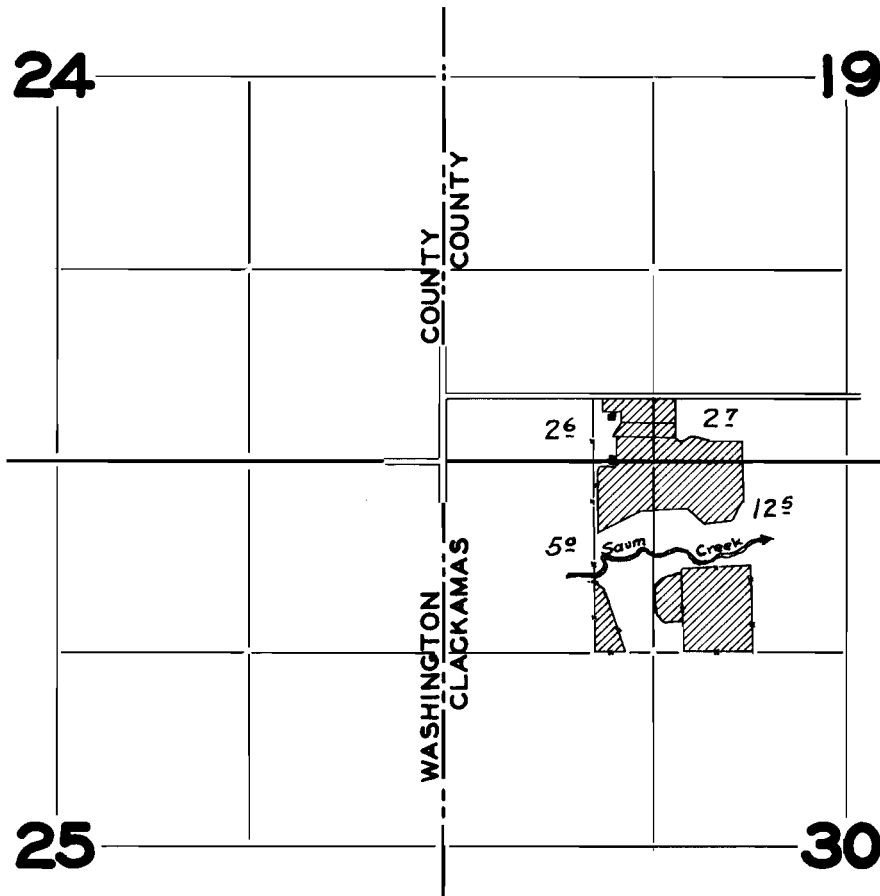

FINAL PROOF SURVEY
UNDER

Application No. 17315 Permit No. 13031

IN NAME OF

Roger Lee

Surveyed July 31, 1942, by Paul Mademan