


T. 8 S., R. 2 W. W.M.

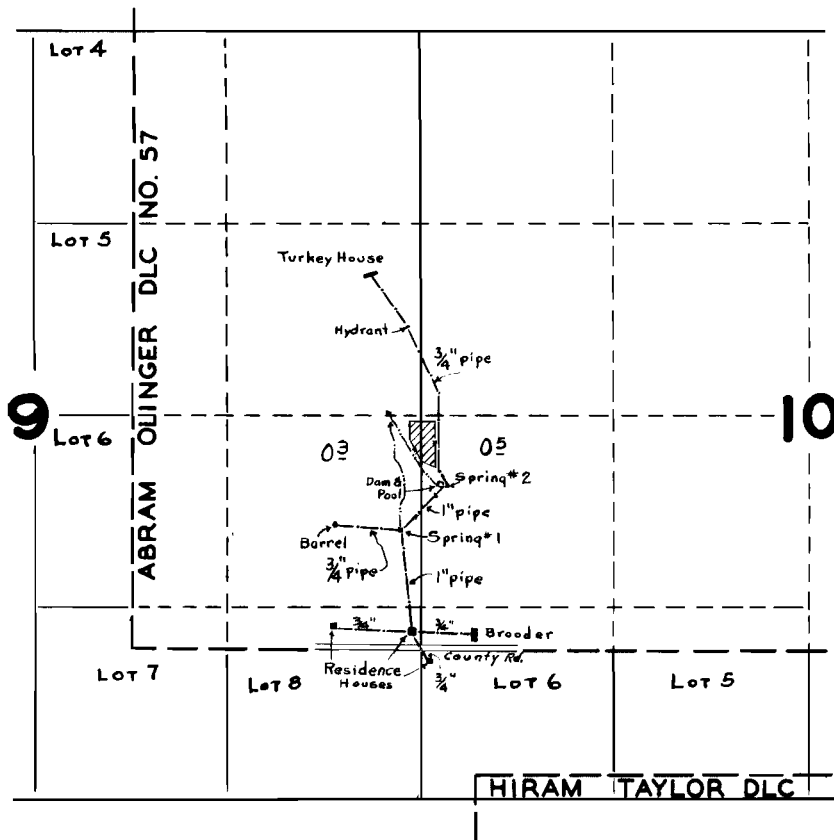

FINAL PROOF SURVEY

UNDER

Application No. 17352 Permit No. 13061

IN NAME OF

Mrs. Mildred Thiessen

Surveyed July 14 1942, by Geol. Maderman