


T. 3 S., R. 1 W. W.M.

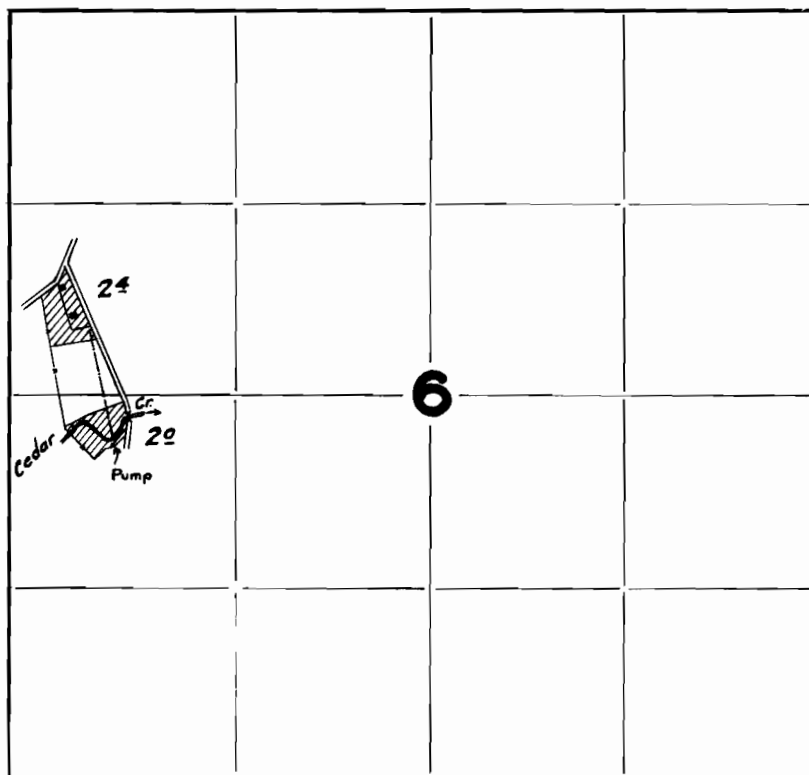

FINAL PROOF SURVEY
UNDER

Application No. 17356 Permit No. 13064

IN NAME OF

J. A. & Leona Rippey

Surveyed Aug. 3 1942, by Geo. W. Anderson