


TOWNSHIP 4S., RANGE 2E.

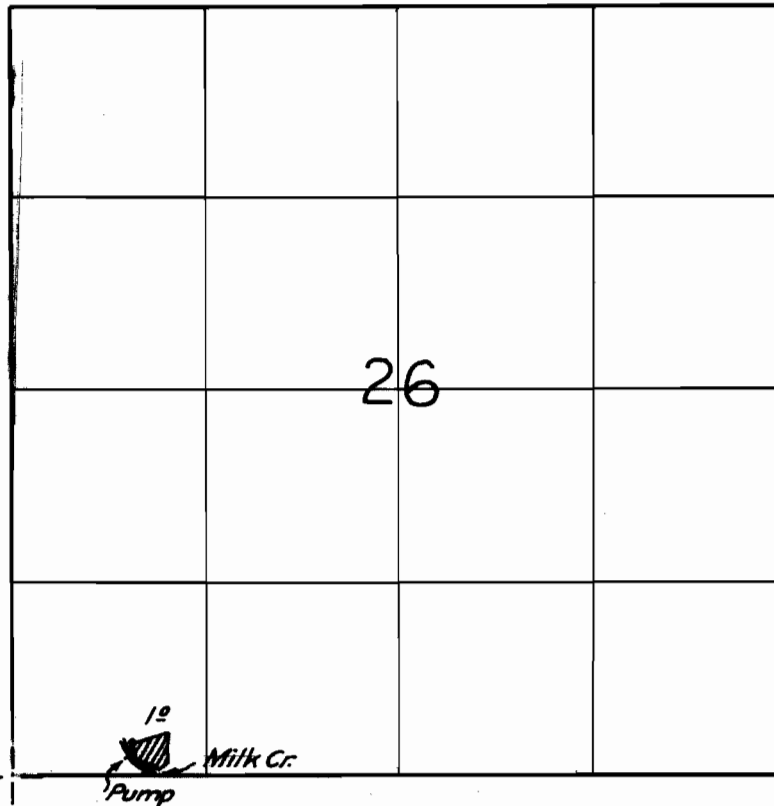

FINAL PROOF SURVEY
UNDER

Application No. 17369 Permit No. 13074

IN NAME OF

Ames D. Wood

Surveyed May 24 1941, by Charles Humming