


T. 4 S., R. 1 E. W.M.

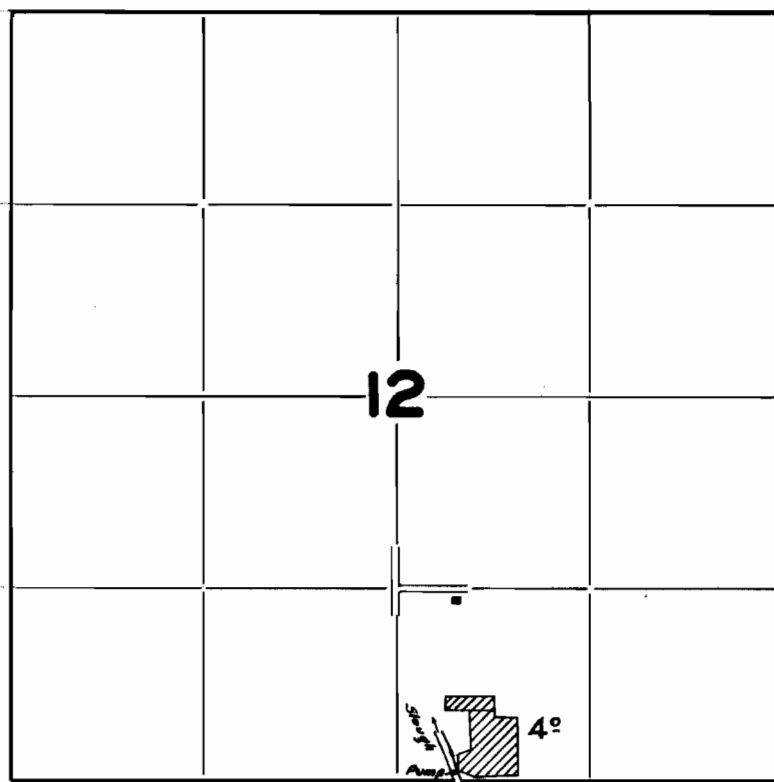

FINAL PROOF SURVEY
UNDER

Application No. 17384 Permit No. 13085
IN NAME OF

Louis F. & Hazel Herr Stewart

Surveyed July 22 1942, by *Geoff Maderman*

Priority
June 22, 1938