


T. 8 S.. R. 3 W. W.M.

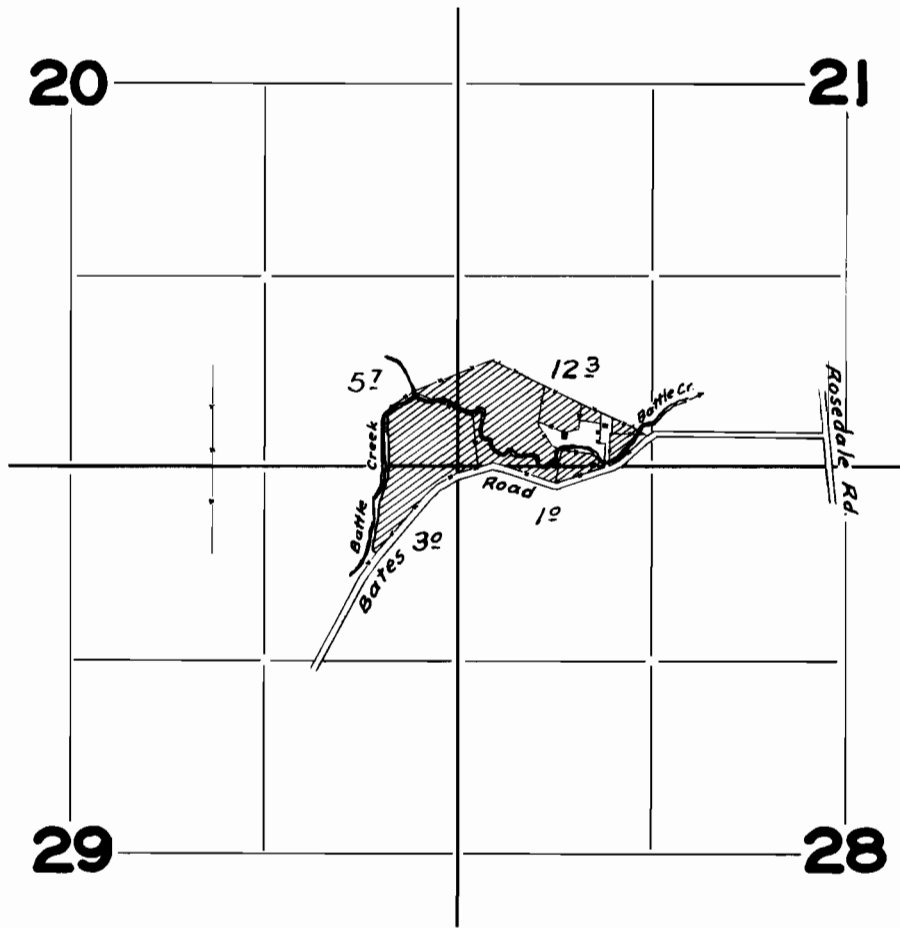

**FINAL PROOF SURVEY
UNDER**

Application No. 17411 Permit No. 13108

IN FAVOR OF

Floyd E. Bates

Surveyed July 13 1942, by Geo. Maderman