


# T. 3 S., R. 3 E. W.M.

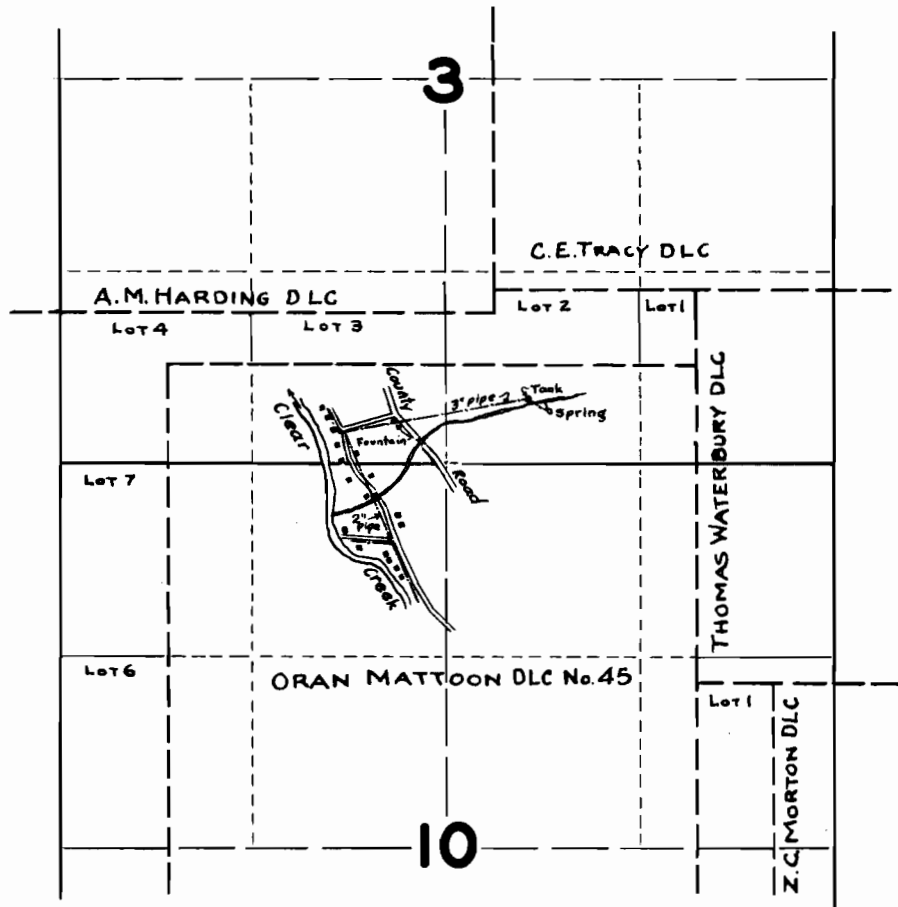

## FINAL PROOF SURVEY UNDER

Application No. 17414 Permit No. 13111

IN NAME OF

A.S. Pattullo Estate

Surveyed July 27, 1942, by Geoff Naderman