


T. 5 S., R. 1 W. W.M.

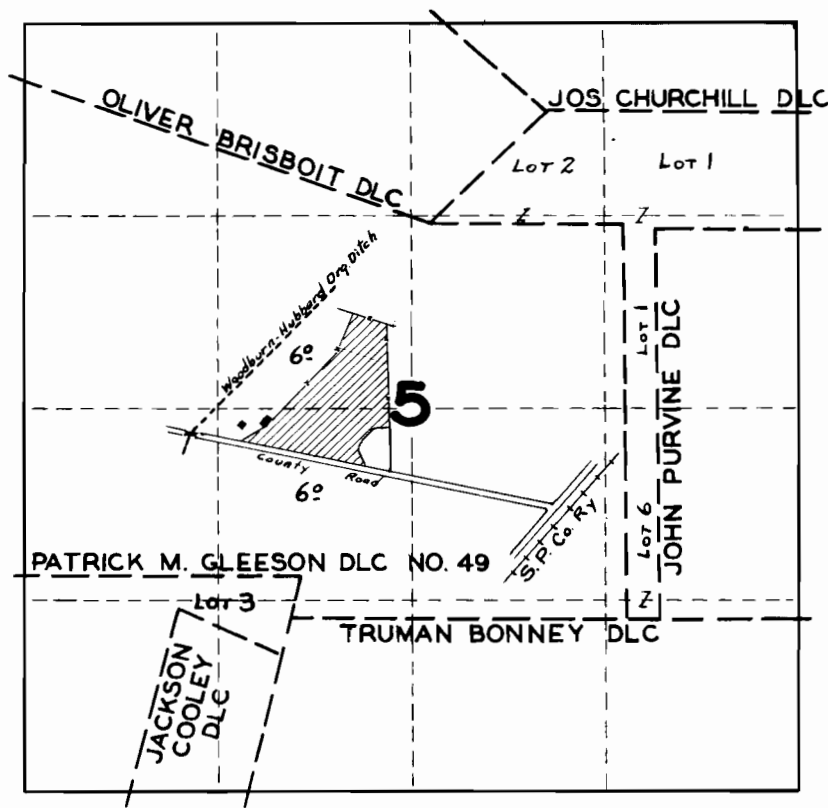

FINAL PROOF SURVEY UNDER

Application No. 17452 Permit No. 13165

IN NAME OF

Paul Simon

Surveyed June 26, 1942, by Geoff Wademan